

KANSAS Sheridan County

Sec. 2 Twp. 6 R. 27W

Well No. #1 W. C. Carlton Farm

Continental Company


Adell

_____ Ft. from N. Line

990 Ft. from S. Line

_____ Ft. from E. Line

990 Ft. from W. Line

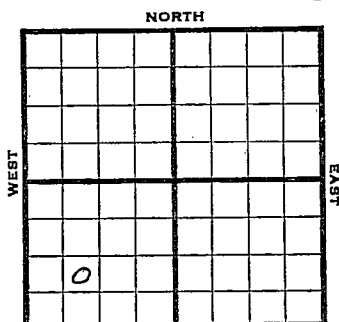

NE SW SW Elev. 256.2

R E P O R T

1944

- 10/25 Location
- 11/2 Drk.
- 11/8 10" @ 242 WOC
- 11/16 Drlg. 2770'
- 11/24 Drlg 3074
- 11/29 Drlg. 3570
- 12/6 Drlg. 3770'
- 12/14 Lans 3585
TD 3814
6" @ 3795' RUST
- 12/21 " " " " " "
- 12/29 48 shots 3610-3625
24 shots 3651-3659
24 shots 3703-3711
58 shots 3736-3754
1800' oil in 8 hrs..

1945

- 1/3 TD 3814 PB 3785
Rip csg 3580-3607
Swb 19 Bbls Oil per Hr

1/10 "

1/17 Lans. 3569

1/26 " "

OVER

1945

1/31

Lans 3569 corrected

6" @ 3795

Perf. Lans -

TD 3814 .

Pump 633 Pot

Grav. 37.2

COMPLETED

Pool Name Adell

KANSAS
 Map No. 735 Sec. 2 Twp. 6 R. 27W

Well No. 1 W. C. Carlton

Continental Company

FIRST REPORT Contractor

NE SW SW


SECTION PLAT

 Ft. from N. Line

990 Ft. from S. Line

 Ft. from E. Line

990 Ft. from W. Line

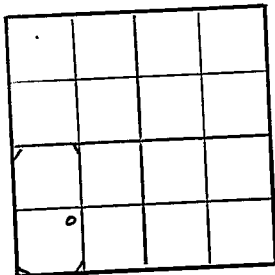

Sheridan

Location X

Rig up

Drilling and Remarks:

RECORD

Cased in., ft.

Sand

Gas

Oil

Total Depth

PRODUCTION

1st 24 hrs. Nat.

1st 24 hrs. after shot

Gas Cu. Ft.

Dry Hole

Abandoned

Date

OCT 25 1944 19

S. J. LEWIS Scout

