

KANSAS

FORM 51 5M BRIX

Sheridan County


Section 2 Township 6 Range 27W

Well No. #1 W. Foster

Company Continental

Adell

NORTH

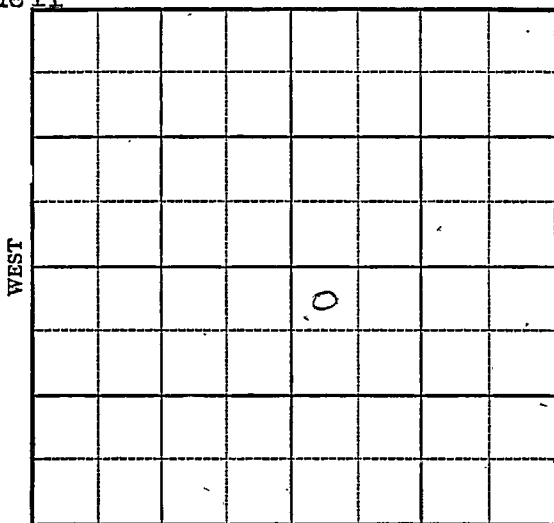

SOUTH

EAST

WEST

10

KANSAS

Sheridan County

Sec. 2 Twp. 6 R. 27W

Well No. #1 W. Foster Farm
Continental Company


Adell

330 Ft. from N. Line

_____ Ft. from S. Line

_____ Ft. from E. Line

330 Ft. from W. Line

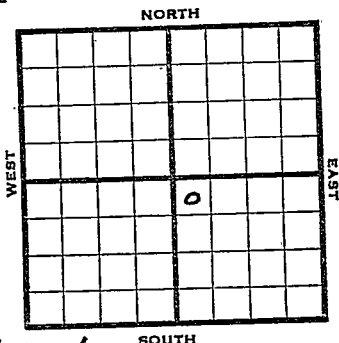

NW SE Elev. 2624

1944

R E P O R T

9/27	Location						
10/4	Rotgry						
10/11	10" @ 242 WOC						
10/18	Drlg. 1980						
10/25	Drlg. 3013						
11/1	Drlg. 3782						
11/8	Lans 3609- TD 3849 6" @ 3847 RUST						
11/16	PB 3840 156 shots 3696 to 3834 Swab. 185 oil in 4 hrs.						
11/24	" " " " " "						
11/29	" " " " " "						
12/6	" " " " " "						
12/14	" " " " " "						
12/21	" " " " " "						
12/29	" " " " " "						
1945							
1/3	" " " " " "						
1/10	" " " " " "						
1/17	" " " " " "						
1/26	" " " " " "						
1/31	" " " " " "						
2/7	" " " " " "						

OVER

1945

2/14

PB 3840 156 shots 3695
to 3834 swb. 184 oil in 4 hrs

2/21

" " " " " " " "

2/28

" " " " " " " "

3/7

" " " " " " " "

3/14

Lans 3609

6" @ 3847

Perf. Lans

TD 3849

Pump 718 Pot.

Grav. 34.0

2
COMPLETED

Pool Name Adell

Map No. 132 **KANSAS** Sec. 2 Twp. 6 R. 27W

Well No. 1 W. Foster

Continental Company

FIRST REPORT Contractor

NW SE

SECTION PLAT

330 Ft. from N. Line

_____ Ft. from S. Line

_____ Ft. from E. Line

330 Ft. from W. Line

		6	

Sheridan County

Location 2

Rig up _____

Drilling and Remarks:

RECORD

Cased _____ in., _____ ft.

Sand _____

Gas _____

Oil _____

Total Depth _____

PRODUCTION

1st 24 hrs. Nat. _____

1st 24 hrs. after shot _____

Gas _____ Cu. Ft.

Dry Hole _____

Abandoned _____

Date

SEP 27 1944 19-

S. J. LEWIS Scout

Pool Name Adell

Map No. 135 Sec. 2 Twp. 6 R. 27W

Well No. 1 W. Foster

Continental Company

COMPLETED Contractor

NW SE

SECTION PLAT

330 Ft. from N. Line

_____ Ft. from S. Line

_____ Ft. from E. Line

330 Ft. from W. Line

		o	

Sheridan

Location _____

Rig up _____

Drilling and Remarks:

Loss 3609

6 " @ 3847

Prof Loss:

Prof 718 P.Y.

342 3/4

RECORD

Cased _____ in., _____ ft.

Sand _____

Gas _____

Oil _____

Total Depth 3847

PRODUCTION

1st 24 hrs. Nat. _____

1st 24 hrs. after shot _____

Gas _____ Cu. Ft.

Dry Hole _____

Abandoned _____

Date

MAR 14 1945

19

S. J. LEWIS

Scout