

KANSAS


FORM 51 5M 6-46 PETROL

Sheridan county,

Section 2 Township 6 Range 27-W

Well No. #4, W. Foster

Company Continental Oil Company

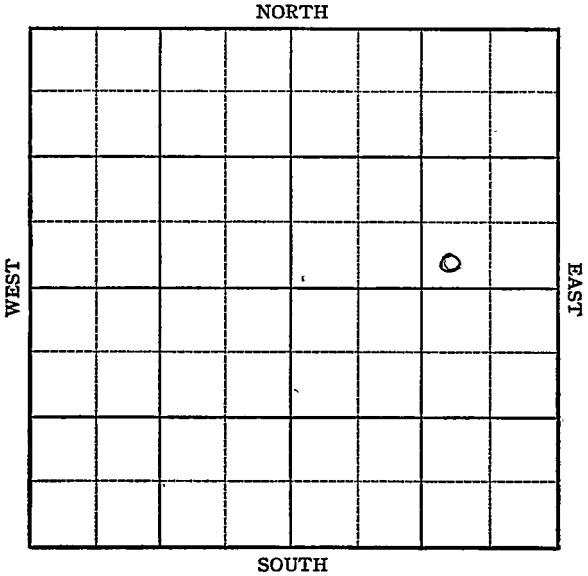

8

Sec. 2 Twp. 6 R. 27W

Well No. 4 W. Foster Farm

Continental Company


Adel

Ft. from N. Line

330 Ft. from S. Line

990 Ft. from E. Line

Ft. from W. Line

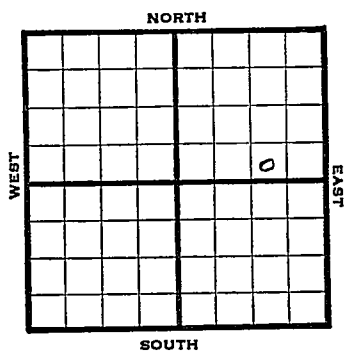

SW SE NE

REPORT

1946 Elev. 2595

- 11/20 Location
- 11/27 RU R
- 12/3 13" @ 240'
Drlg 2668'
- 12/10 Drlg 3646'
- 12/17 Lans 3602'
Arb 4055'
TD 4076, run csg.

1947

- 1/4 5" @ 4076
PB 4030'
30 shots 3816-3830 3 gals WPH
30 shots 3794-3805 " "
48 shots 3772-8788 1/4 oil plus
1/4 W PH
24 shots 3748-58
Swb 25 gals oil PH

1/8 " " "

1/15 3000 Acid 3794-3808
and 3772-88

1/21 Squeeze

1/30

OVER

2/5 Swb 21 oil & 115 W in 20 hrs
2/12 " " "
2/19 " " "
2/26 Lans 3602
Arb 4055
5" @ 4076'
Perf
3000 Acid
Pump 12 oil & 138 W Pot
Grav. 36
TD 4076½

COMPLETED

Map No. 135 Sec. 2 Twp. 6 R. 27W

Well No. 4 W. Foster

Continental Company

FIRST REPORT

Contractor

SW SE NE

SECTION PLAT

			o

 Ft. from N. Line

330 Ft. from S. Line

990 Ft. from E. Line

 Ft. from W. Line

Sheridan County

Location X

Rig up

Drilling and Remarks:

RECORD

Cased in., ft.

Sand

Gas

Oil

Total Depth

PRODUCTION

1st 24 hrs. Nat.

1st 24 hrs. after shot

Gas Cu. Ft.

Dry Hole

Abandoned

Date

NOV 20 1946 19

S. J. LEWIS Scout

Map No. 135 Sec. 2 Twp. 6 R. 27W

Well No. 4 W. Foster

Continental Company

COMPLETE

Contractor

SW SE NE

F12585
SECTION PLAT

			0

 Ft. from N. Line
330 Ft. from S. Line
990 Ft. from E. Line
 Ft. from W. Line

Sheridan County

RECORD

Location

Cased in., ft.

Rig up

Sand

Drilling and Remarks:

Gas

Loss 3602

Oil

Or 4055

Total Depth 4096

5 2 40 76

*Prof. Burns.
 8000 acid*

PRODUCTION

1st 24 hrs. Nat.

1st 24 hrs. after shot

Gas Cu. Ft.

Run 12 oil 6738W

Dry Hole

Abandoned

Post

36 2/2

Date

FEB 26 1947 19

S. J. LEWIS Scout