


Section 2 Township 6 Range 27W

Well No. #2 W. R. Foster

Company Continental

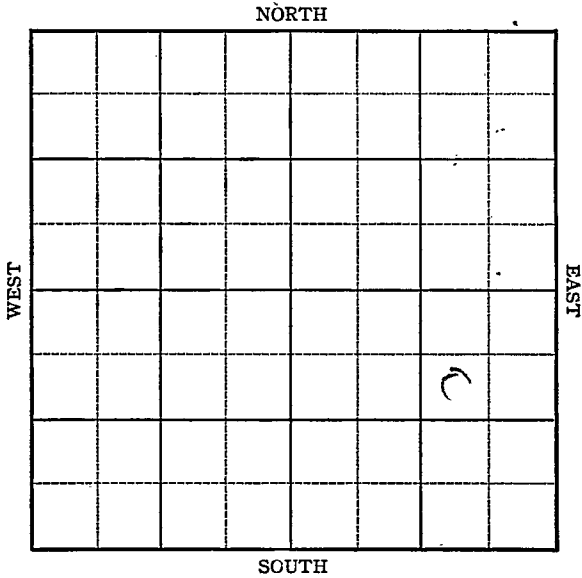

9

KANSAS

Sheridan County

Sec. 2 Twp. 6S R. 27W

Well No. #2, W. R. Foster Farm

Continental Company

SW NE SE


990 Ft. from N. Line

Ft. from S. Line

990

Ft. from E. Line

Ft. from W. Line

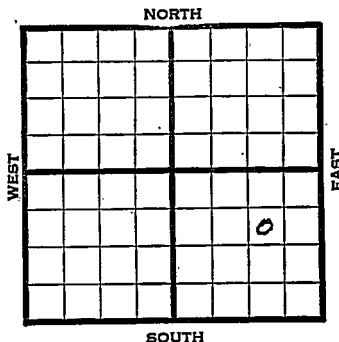

Plus 2613'

1945

REPORT

- 4-4 Location
- 4/12 Derrick
- 4/20 "
- 4/26 RUR
- 5/3 10" @ 240
Drlg. 831
- 5/10 Drlg. 2556
- 5/17 Drlg. 3258
- 5/24 S.D. 3258
- 5/31 Drlg. 3535
- 6/8 Lans 3607 TD 3658 7" @ 3657 RUST
- 6/21 Drlg. 3757
3000' oil SSW
- 6/28 TD 3771 CO
- 7/3 TD 3772
3000' oil
5" @ 3772' RUST
- 7/11 Drlg. 3825
3000' oil
- 7/19 TD 3850'
5" @ 3848' RUST
- 7/26 5" @ 3824 corrected
- 8/1 " " "
- 8/8 " " "
- 8/15 " " "
- 8/22 " " "
- 8/29 " " "
- 9/5 " " "
- 9/12 " " "
- 9/19 " " "

OVER

1945

9/26 5" @ 3824
10/3 " "
10/10 " "
10/17 5" @ 3848
24 shots 3690-3708 wtr.
Squeeze
10/24 142 shots 3604-3740
1000 acid. Swb. 50 oil per hr. 2 hrs.
10/31 " " " " " " " "
13/7 Lans 3607
7" @ 3657
5" @ 3790
Perf.
1000 acid.
TD 3850
Pump 849 Pot.
Grav. 36.0

COMPLETED

Pool Name AdelMap No. 1135 Sec. 2 Twp. 6 R. 27WWell No. 2 W.R. FosterContinental Company

FIRST REPORT

Contractor

SW NE SE

SECTION PLAT

990 Ft. from N. Line Ft. from S. Line990 Ft. from E. Line Ft. from W. Line

		2	
		4.1	
			0

Sheridan

Location XRig up Drilling and Remarks:

RECORD

Cased in., ft.Sand Gas Oil Total Depth

PRODUCTION

1st 24 hrs. Nat. 1st 24 hrs. after shot Gas Cu. Ft.Dry Hole Abandoned

Date

APR 4 1945S. J. LEWIS Scout

Pool Name Adel

KANSAS

Kansas

Map No. 135 Sec. 2 Twp. 6 R. 27W

Well No. 2 W. R. Foster

Continental Company

COMPLETED

Contractor

SW NE SE

E1.26/3
SECTION PLAT

990 Ft. from N. Line

1 Ft. from S. Line

990 Ft. from E. Line

 Ft. from W. Line

Sheridan County

Location _____

Rig up _____

Drilling and Remarks:

Liams 3607

7" @ 3657

5" @ 3790

Perf.

100 acid

*Pump 849 BX
362-24*

RECORD

Cased _____ in., _____ ft.

Sand _____

Gas _____

Oil _____

Total Depth 3850

PRODUCTION

1st 24 hrs. Nat. _____

1st 24 hrs. after shot _____

Gas _____ Cu. Ft.

Dry Hole _____

Abandoned _____

Date

NOV 7 1945 19

S. J. LEWIS Scout