

KANSAS

FORM 51 10M 12-46 PETROL

Sheridan

Section 2 Township 6 Range 27-W

Well No. 5 Foster

Company Continental

Adel Pool

NORTH

WEST

EAST

SOUTH

10

KANSAS

Sheridan ✓

Sec. 2 Twp. 6 R. 27W

Well No. 5 Foster Farm

Continental Company


Adel Pool

990 Ft. from N. Line

_____ Ft. from S. Line

_____ Ft. from E. Line

990 Ft. from W. Line

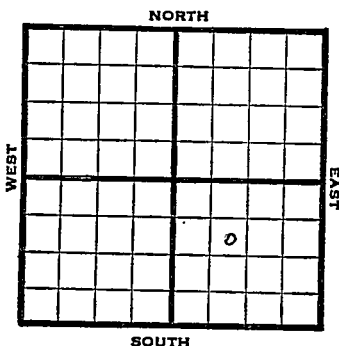

SE NW SE

1947

Elev. 2640' REPORT

8/13

Drlg. 261'

8/20

10" @ 243

Drlg. 3010'

8/27

TD 3878'

6" @ 3877

RUST

9/3

" "

9/10

51 shots 8702-22

swb 8 oil PH 6 hrs.

9/17

" "

9/24

Lans. 3598'

6" @ 3877'

Perf.

Pump 426 Pot

27.4 Gr.

TD 3878'

COMPLETED

Map No. _____ Sec. 2 Twp. 6 R. 27W

Well No. 5 Foster

Continental Company

FIRST REPORT Contractor

SE NW SE

SECTION PLAT

990 Ft. from N. Line

_____ Ft. from S. Line

_____ Ft. from E. Line

990 Ft. from W. Line

Sheridan County

RECORD

Location _____

Cased _____ in., _____ ft.

Rig up _____

Sand _____

Drilling and Remarks:

Gas _____

Oil _____

Total Depth _____

drlg. 261

PRODUCTION

1st 24 hrs. Nat. _____

1st 24 hrs. after shot _____

Gas _____ Cu. Ft.

Dry Hole _____

Abandoned _____

Date

AUG 13 1947 19

S. J. LEWIS Scout

