


Section 2 Township 6 Range 21W

Well No. #1 Templeton

Company W.L. Hartman

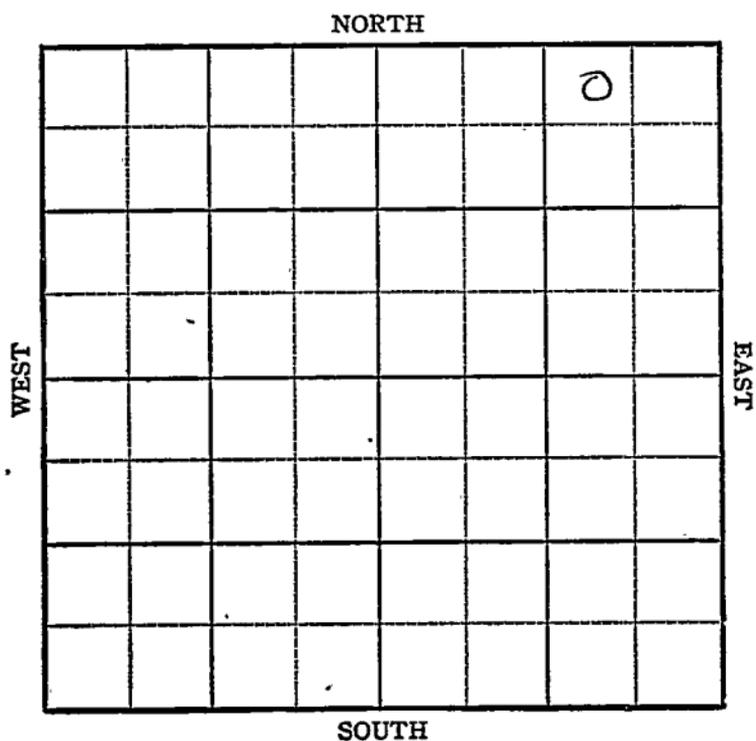

Graham

Sec. 2 Twp. 6 R. 21W

Well No. #1 Templeton Farm

W. L. Hartman Company

Contractor


330' **Ray Pool**
Ft. from N. Line

Ft. from S. Line

990' Ft. from E. Line

Ft. from W. Line

NW NE NE

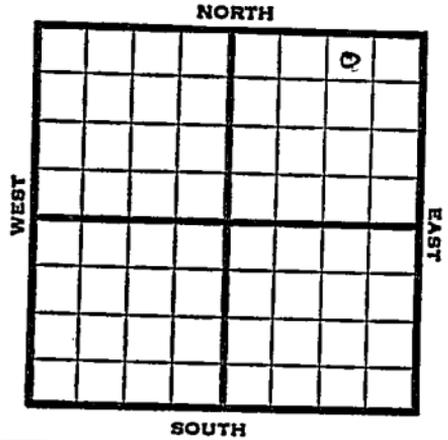

1951

Elev. 2210' REPORT

5/29

Location

6/13

Spud 5-12-51

6/13

Spud 5-12-51

D & A TD 3612' 8" @ 150

Top. 3144' Heeb 3341' KC 3367'

DST 3376-92 open 30 min. rec 5' mud

B KC 3575' TD 3621' D & A

ABANDONED


County Graham State Kansas

Sec. 2 (Blk. 6 (Sur. Rge.) 21W Map No.

Operator W. L. Hartman

Well No. 1 Farm Templeton

Elev. 2210 Location NW NE NE

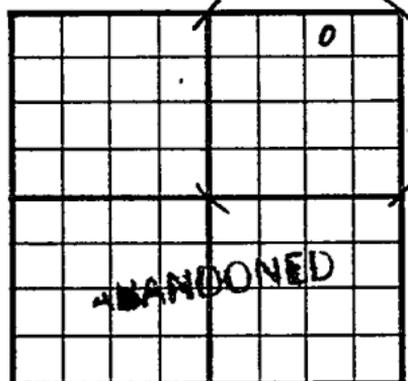

330 Ft. From N Line NE

990 Ft. From E Line Quarter

Ist. Report

Completion JUN 13 1951

Remarks Ray Pool

Spudding Date 5-12-51

Drlg. Data D & A TD 3612

8" @ 150 Top. 3144 Heeb. 3341

KC 3367 DST 3376-92 open 30 min.

Rec. 5' mud B KC 3575 TD 3621

D & A

J. E. TVRA