

STATE CORPORATION COMMISSION OF KANSAS
OIL & GAS CONSERVATION DIVISION

WELL COMPLETION OR RECOMPLETION FORM
ACO-1 WELL HISTORY

DESCRIPTION OF WELL AND LEASE

Operator: license # 5198
name A. Scott Ritchie
address 125 N. Market
Suite 950
City/State/Zip Wichita, KS 67202

Operator Contact Person Jeff Christian
Phone (316) 267-4375

Contractor: license # 6033
name Murfin Drilling Co.

Wellsite Geologist Bob Buffo
Phone (316) 267-4375

PURCHASER Koch Oil Company

Type of Completion

☒ New Well ☐ Re-Entry ☐ Workover

☒ Oil ☐ SWD ☐ Temp Abd
☐ Gas ☐ Inj ☐ Delayed Comp.
☐ Dry ☐ Other (Core, Water Supply etc.)

If OWWO: old well info as follows:

Operator
Well Name
Comp. Date Old Total Depth

WELL HISTORY

Drilling Method: ☒ Mud Rotary ☐ Air Rotary ☐ Cable

4/4/85 4/13/85 5/12/85
Spate Date Reached TD Completion Date

3787' RTD 3580'

Total Depth PBD

At of Surface Pipe Set and Cemented at 219 feet

Multiple Stage Cementing Collar Used? ☒ Yes ☐ No

If Yes, Show Depth Set 1818 feet

If alternate 2 completion, cement circulated
from 219 feet depth to surface w/ 175 SX cmt

Wireline Log Rec'd

API NO. 15- 163-22,655

County Rooks

SW NW NW Sec 28 Twp 6S Rge 20
(location)

4290 Ft North from Southeast Corner of Sec
4950 Ft West from Southeast Corner of Sec
(Note: locate well in section plat below)


Lease Name Nanette Hilgers Well# 1

Field Name Unknown

Producing Formation Lansing

Elevation: Ground 2208' KB 2213'

Section Plat

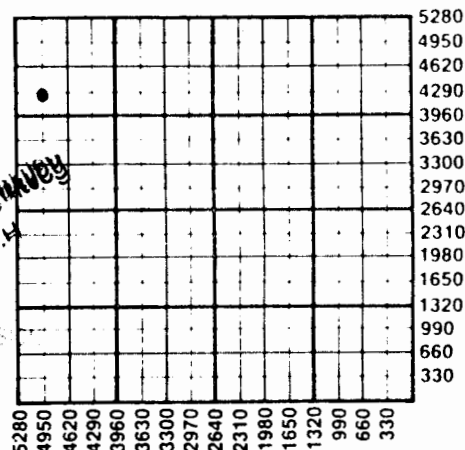

JUN 24 1985
State Geologist Survey
WICHITA BRANCH
JUN 21 1985

WATER SUPPLY INFORMATION

Source of Water:

Division of Water Resources Permit #

☐ Groundwater (Well) Ft North From Southeast Corner
Ft West From Southeast Corner

Sec Twp Rge ☐ East ☐ West

☐ Surface Water (Stream, Pond etc.) Ft North From Southeast Corner
Ft West From Southeast Corner

Sec Twp Rge ☐ East ☐ West

☐ Other (explain) (purchased from city, R.W.D. #)

Disposition of Produced Water: ☐ Disposal

☐ Repressuring

Docket #

INSTRUCTIONS: This form shall be completed in duplicate and filed with the Kansas Corporation Commission, 200 Colorado Derby Building, Wichita, Kansas 67202, within 90 days after completion or recompletion of any well. Rules 82-3-130 and 82-3-107 apply.

Information on side two of this form will be held confidential for a period of 12 months if requested in writing and submitted with the form. See rule 82-3-107 for confidentiality in excess of 12 months.

copy of all wireline logs and drillers time log shall be attached with this form. Submit CP-4 form with all plugged wells. Submit CP-111 form with rarely abandoned wells.