SIDE ONE

30-6-20W

STATE CORPORATION COMMISSION OF KANSAS
OIL & GAS CONSERVATION DIVISION
WELL COMPLETION FORM
ACO-1 WELL HISTORY
DESCRIPTION OF WELL AND LEASE

Operator: License # 4767

Name: Ritchie Exploration, Inc.

Address 125 N. Market, Suite 1000

City/State/Zip Wichita, KS 67202

Purchaser: n/a

Operator Contact Person: Jeff Christian

Phone (316) 267-4375

Contractor: Name: Murfin Drilling Co

License: 6033

Wellsite Geologist: Bob Mathiesen

PLEASE KEEP THIS INFORMATION CONFIDENTIAL
OCT 04 1989
KANSAS GEOLOGICAL SURVEY
WICHITA BRANCH

Designate Type of Completion
X New Well ____ Re-Entry ____ Workover

____ Oil ____ SWD ____ Temp. Abd.
____ Gas ____ Inj ____ Delayed Comp.
X Dry ____ Other (Core, Water Supply, etc.)

RECEIVED
STATE CORPORATION COMMISSION
OCT 03 1989
CONSERVATION DIVISION
Wichita, Kansas

If OWWO: old well info as follows:
Operator:
Well Name:
Comp. Date ____ Old Total Depth ____

Drilling Method:
X Mud Rotary ____ Air Rotary ____ Cable

5/06/89 | 5/13/89 | 5/13/89
Spud Date | Date Reached TD | Completion Date

API NO. 15- 163-23,046

County Rooks

SE NW NW Sec. 30 Twp. 6 Rge. 20 XX East West

4290 Ft. North from Southeast Corner of Section

4290 Ft. West from Southeast Corner of Section
(NOTE: Locate well in section plat below.)


Lease Name W.L. Nichols Well # 1

Field Name wildcat

Producing Formation n/a

Elevation: Ground 2263' KB 2268'

Total Depth 3780' PBTD n/a

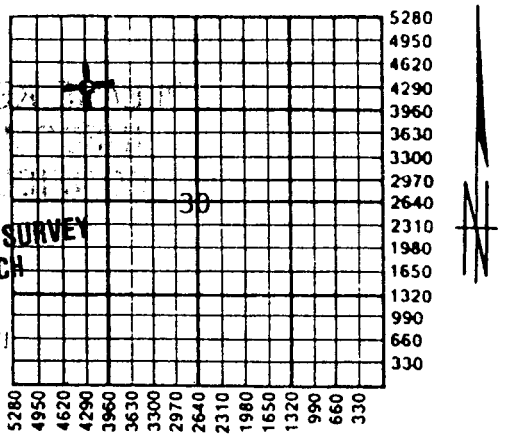

Amount of Surface Pipe Set and Cemented at 210 Feet

Multiple Stage Cementing Collar Used? ____ Yes X No

If yes, show depth set ____ Feet

If Alternate II completion, cement circulated from ____

feet depth to ____ w/ ____ sx cmt.

INSTRUCTIONS: This form shall be completed in triplicate and filed with the Kansas Corporation Commission, 200 Colorado Derby Building, Wichita, Kansas 67202, within 120 days of the spud date of any well. Rule 82-3-130, 82-3-107 and 82-3-106 apply. Information on side two of this form will be held confidential for a period of 12 months if requested in writing and submitted with the form. See rule 82-3-107 for confidentiality in excess of 12 months. **One copy of all wireline logs and drillers time log shall be attached with this form. ALL CEMENTING TICKETS MUST BE ATTACHED.** Submit CP-4 form with all plugged wells. Submit CP-111 form with all temporarily abandoned wells. Any recompletion, workover or conversion of a well requires filing of ACO-2 within 120 days from commencement date of such work.

All requirements of the statutes, rules and regulations promulgated to regulate the oil and gas industry have been fully complied with and the statements herein are complete and correct to the best of my knowledge.

Signature

Title Vice President Date 8/30/89

Subscribed and sworn to before me this 30th day of August, 19 89.

Notary Public Linda K. Rice

Date Commission Expires 6/07/92

LINDA K. RICE
NOTARY PUBLIC
STATE OF KANSAS
My Appt. Exp. 6-7-92

K.C.C. OFFICE USE ONLY
F ✓ Letter of Confidentiality Attached
C ✓ Wireline Log Received
C ✓ Drillers Timelog Received

Distribution
✓ KCC ____ SWD/Rep ____ NGPA
✓ KGS ____ Plug ____ Other (Specify)

Form ACO-1 (7-89)