
FORM 5I 5M PETROL

KANSAS

Section 20 Township 6 Range 23W

Well No. 1 McKim -

Company Cities Service

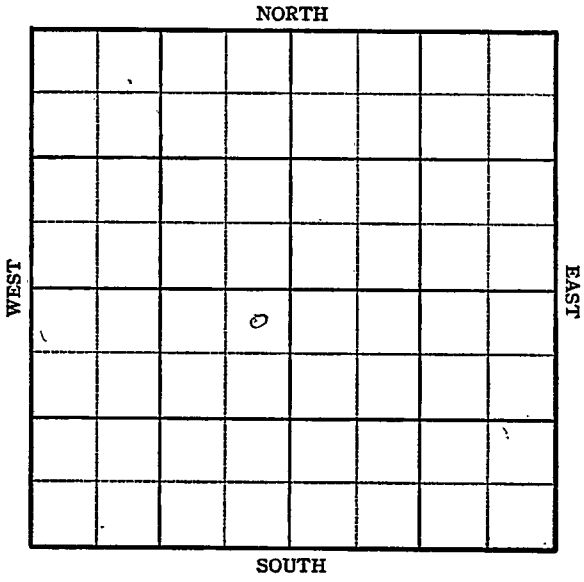

11

FORM 252-A
5M 8-45 PETROL

KANSAS Graham

Sec. 20 Twp. ~~26~~ 6 R. 23-W

Well No. #1 McKim Farm

Cities Service Company


330 Ft. from N. Line

_____ Ft. from S. Line

330 Ft. from E. Line

_____ Ft. from W. Line

NE SW

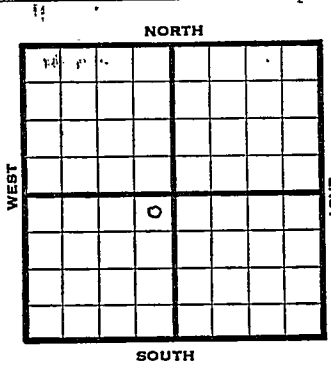

1945	Elev. 2362 REPORT
10/17	Location
10/24	8" @ 311 Drlg. 830
10/31	Drlg. 3340
11/7	Lans 3506 Cong 3979 Simp 3994 Arb. 4005 D 4040'

ABANDONED

FORM 26 200 BKS 1-44 PETROL

KANSAS Kansas Pool Name Wildcat

Map No. 134 Sec. 20 Twp. 6 R. 23W

Well No. 1 McKine

Cities Service Company

CORRECTION Contractor

NE SW


330 Ft. from N. Line

Ft. from S. Line

330 Ft. from E. Line

Ft. from W. Line

SECTION PLAT

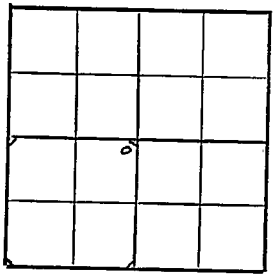

Graham County

Location

Rig up

Drilling and Remarks:
reported
20-26-23W

RECORD

Cased in., ft.

Sand

Gas

Oil

Total Depth

PRODUCTION

1st 24 hrs. Nat.

1st 24 hrs. after shot

Gas Cu. Ft.

Dry Hole

Abandoned

Date

OCT 17 1945 19 S. J. LEWIS Scout

FORM 26 39-16-45 KANSAS PETROL

Kansas Pool Name Wildcat

Map No. Sec. 20 Twp. 26 R. 23W

Well No. 1 McKim

Cities Service Company

FIRST REPORT Contractor

NE SW


330 Ft. from N. Line

Ft. from S. Line

330 Ft. from E. Line

Ft. from W. Line

SECTION PLAT

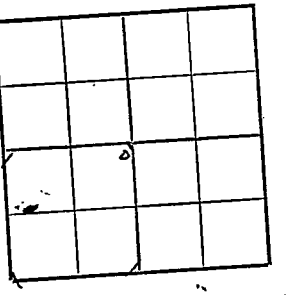

Graham County

Location X

Rig up

Drilling and Remarks:

RECORD

Cased in., ft.

Sand

Gas

Oil

Total Depth

PRODUCTION

1st 24 hrs. Nat.

1st 24 hrs. after shot

Gas Cu. Ft.

Dry Hole

Abandoned

Date

OCT 17 1945 19 S. J. LEWIS Scou

FORM 26 200 BKS 1-44 PETROL

KANSAS Kansas

Pool Name Graham

Map No. 134 Sec. 20 Twp. 6 R 23W

Well No. 1 McKim

Cities Service Company

CORRECTION Contractor

NE SW


330 Ft. from N. Line

Ft. from S. Line

330 Ft. from E. Line

Ft. from W. Line

SECTION PLAT

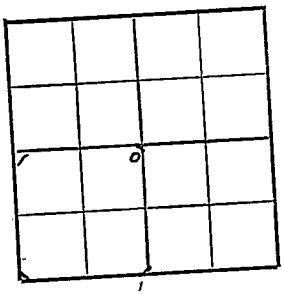

Wildcat

Location

Rig up

Drilling and Remarks:

reported 20-26-23W

RECORD

Cased in., ft.

Sand

Gas

Oil

Total Depth

PRODUCTION

1st 24 hrs. Nat.

1st 24 hrs. after shot

Gas Cu. Ft.

Dry Hole

Abandoned

Date

OCT 24 1945 19

S. J. LEWIS Scout

FORM 56 200 BKS. 1-44 PETROL

KANSAS Kansas Pool Name Wildcat

Map No. 1 34 Sec. 20 Twp. 6 R. 23W

Well No. 1 McKim


Cities Service Company

ABANDONED Contractor

NE SW

E 12362

SECTION PLAT

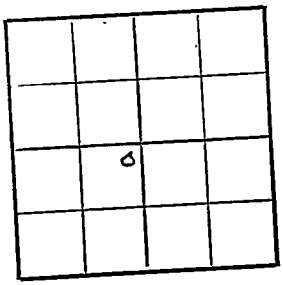

330 Ft. from N. Line

Ft. from S. Line

330 Ft. from E. Line

Ft. from W. Line

Graham County

Location

Rig up

Drilling and Remarks:

Lans 3506
Org 3979
Stal 3994
Arb 4005

RECORD

Cased in., ft.

Sand

Gas

Oil

Total Depth 4040

PRODUCTION

1st 24 hrs. Nat.

1st 24 hrs. after shot

Gas Cu. Ft.

Dry Hole

Abandoned

Date

NOV 7 1945 19

S. J. LEWIS Scout