


Section 20 Township 6 Range 25-W

Well No. #36 Strat Jackson

Company Continental

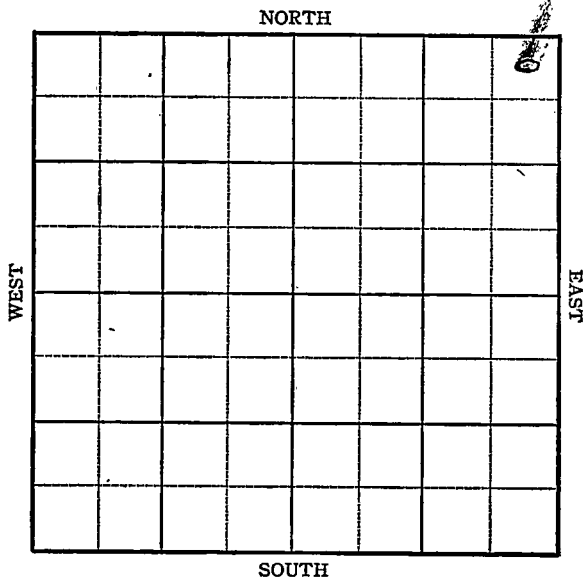

Sec. 20 Twp. 6 R. 25W

Well No. #36 Strat Jackson Farm

Continental Company

Wildcat


330 Ft. from N. Line

\_\_\_\_\_ Ft. from S. Line

330 Ft. from E. Line

\_\_\_\_\_ Ft. from W. Line

NE/c

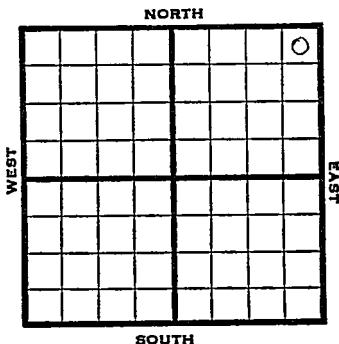

1946

Elev. 2603

REPORT

3/6

Lans. 3692  
SO 3740-3746, 3753-3759, 3860-3865  
Cong 4120  
TD 4214'

**FIRST REPORT**

&

**ABANDONED**

