


Section 20 Township 6 Range 26W

Well No. #1 Glasgow

Company Harry Gore

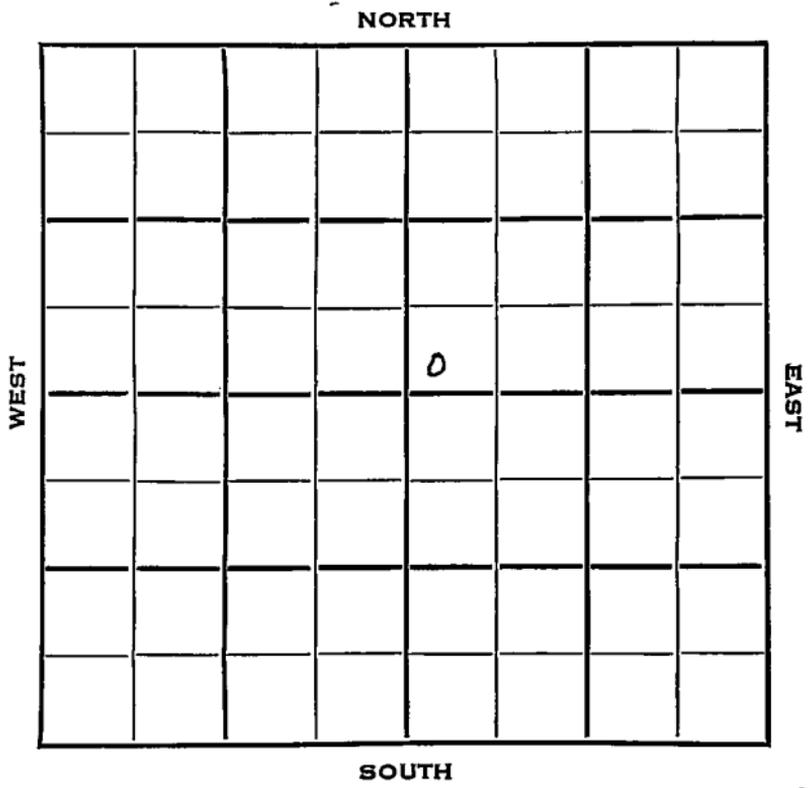

Sheridan

KANSAS

Sec. 20 Twp. 6 R. 26 W

Well No. # 1 Glasgow Farm

Harry Gore Company

Veeder Contractor

Hortonville Pool


_____ Ft. from N. Line

330 Ft. from S. Line

_____ Ft. from E. Line

330 Ft. from W. Line

SW SW NE

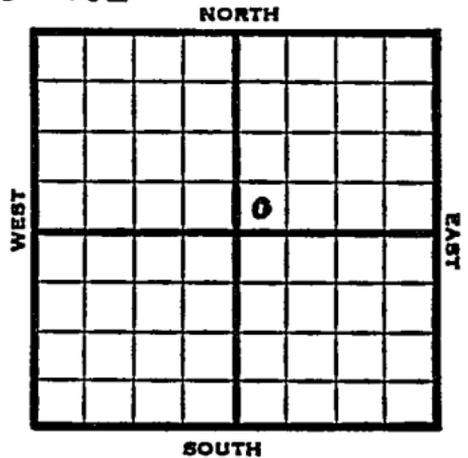

1953	Elev. 2660' REPORT
2/11	Spud 2-5-53 8" @ 334 Anhy 2258' Drlg. 2265'
2/20	Heeb 3710' Tor 3724' KC 3748' DST 3770-94, 1 hr, 8' M 490# DST 3794-3824, 1 hr, 4' M 0# Drlg. 3852'
2/25	Spud 2-5-53 D & A TD 3970' 8" @ 334 Anhy 2258 Heeb 3710 Tor 3724 KC 3748' DST 3770-94 open 1 hr. rec 8' mud 490# DST 3794-3824 open 1 hr. rec 4' mud 0# Cored 3770-94 red 24' VSSO Cored 3794-3824 rec 30' SSO Cored 3824-52 rec 28' SSO B KC 3958' TD 3970' D & A
<p>ABANDONED</p>	


County Sheridan State Kansas

Sec. 20 (Blk. Twp.) 6 (Sur. Rge.) 26W Map No.

Operator Harry Gore

Well No. 1 Farm Glasgow

Elev. Location SW SW NE

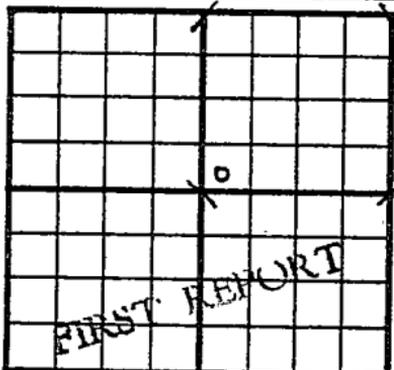

330 Ft. From S Line NE

330 Ft. From W Line Quarter

Ist. Report FEB 11 1953

Completion

Remarks

Veeder - Contr.

Spudding Date 2-5-53

Drlg. Data Hortenville Pool

8" @ 334 Anhy 2258 drlg. 2265


County Sheridan State Kansas

Sec. 20 (Blk. Twp.) 6 (Sur. Rge.) 26W Map No.

Operator Harry Gore

Well No. 1 Farm Glasgow

Elev. 2660 Location SW SW NE

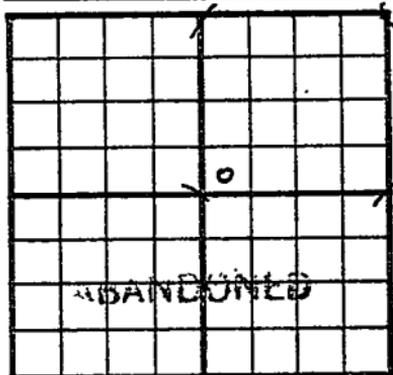

330 Ft. From S Line NE

330 Ft. From W Line Quarter

1st. Report

FEB 25 1953

Completion

Remarks Horton ville Pool

Veeder - Contr.

Spudding Date 2-5-53

Drlg. Data D & A TD 3970

8" @ 334 Anyh 2258 Heeb. 3710

Tor. 3724 KC 3748 DST 3770-94

open 1 hr. Rec. 8' mud 490# DST 3794-

3824 open 1 hr. Rec. 4' mud 0#

Cored 3770-94 Rec. 24' VSSO Cored 3794-

3824 Rec. 30' SSO Cored 3824-52

Rec. 28' SSO B KC 3958 TD 3970

D & A

J. G. McGEHEE