

STATE CORPORATION COMMISSION OF KANSAS
OIL & GAS CONSERVATION DIVISION

WELL COMPLETION OR RECOMPLETION FORM
ACO-1 WELL HISTORY

DESCRIPTION OF WELL AND LEASE

Operator: license # 5198
name A. Scott Ritchie
address 125 N. Market, Suite 950
City/State/Zip Wichita, KS 67202

Operator Contact Person Galen Babcock
Phone (316) 267-4375

Contractor: license # 6033
name Murfin Drilling Co.

Wellsite Geologist Rich Robba
Phone (316) 264-6653

Derive Type of Completion

☒ New Well ☐ Re-Entry ☐ Workover
☒ Oil ☐ SWD ☐ Temp Abd
☐ Gas ☐ Inj ☐ Delayed Comp.
☐ Dry ☐ Other (Core, Water Supply etc.)

If OWWO: old well info as follows:

Operator
Well Name
Comp. Date Old Total Depth

WELL HISTORY

Drilling Method: ☒ Mud Rotary ☐ Air Rotary ☐ Cable
5/31/84 6/9/84 7/20/84
Spurte Date Reached TD Completion Date

3702' N/A
Total Depth PBTD

Amount of Surface Pipe Set and Cemented at 259 feet

Multiple Stage Cementing Collar Used? ☒ Yes ☐ No

If Yes, Show Depth Set 1809' feet

If alternate 2 completion, cement circulated
from 259 feet depth to surface w/ 180 SX cmt

API NO. 15 - 065-21,998

County Graham

1410' FSL, 340' FWL SW/4
(location) Sec 8 Twp 6 Rge 21 X We

1410' Ft North from Southeast Corner of Section
4940' Ft West from Southeast Corner of Section
(Note: locate well in section plat below)


Lease Name Carl Boys Well# 1

Field Name Boys, SO

Producing Formation Lansing

Elevation: Ground 2189' KB 2194'

Section Plat

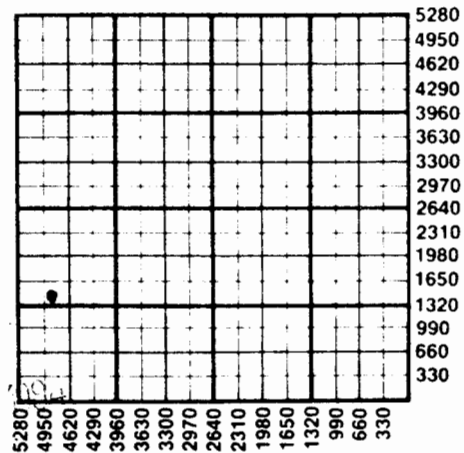

WATER SUPPLY INFORMATION

Source of Water:

Division of Water Resources Permit #

☐ Groundwater. Ft North From Southeast Corner and
(Well) Ft. West From Southeast Corner
Sec Twp Rge ☐ East ☐ West

☒ Surface Water. Ft North From Southeast Corner and
(Stream, Pond etc.) Ft West From Southeast Corner
Sec Twp Rge ☐ East ☐ West

☐ Other (explain) Pumped from Bow Creek
(purchased from city, R.W.D.#)

Disposition of Produced Water: ☐ Disposal ☐ Repressuring

Docket #

INSTRUCTIONS: This form shall be completed in duplicate and filed with the Kansas Corporation Commission, 200 Colorado Derby Building, Wichita, Kansas 67202, within 90 days after completion or recompletion of any well. Rules 82-3-130 and 82-3-107 apply.

Information on side two of this form will be held confidential for a period of 12 months if requested in writing and submitted with the form. See rule 82-3-107 confidentiality in excess of 12 months.

of all wireline logs and drillers time log shall be attached with this form. Submit CP-4 form with all plugged wells. Submit CP-111 form with all abandoned wells.