

md

S

9-6-21W

SIDE ONE

STATE CORPORATION COMMISSION OF KANSAS
OIL & GAS CONSERVATION DIVISION
WELL COMPLETION FORM
ACO-1 WELL HISTORY
DESCRIPTION OF WELL AND LEASE

API NO. 15- 065,22,535

County Graham
130' E of
SE SW NE Sec. 9 Twp. 6S Rge. 21W East West

Operator: License # 4767

2970 Ft. North from Southeast Corner of Section

Name: Ritchie Exploration, Inc.

1520 Ft. West from Southeast Corner of Section

Address 125 N. Market, Suite 1000

(NOTE: Locate well in section plat below.)

City/State/Zip Wichita, KS 67202

Lease Name Beecher Well # 1

Purchaser: Koch Oil Co.

Field Name Boys East

Operator Contact Person: Jeff Christian

Producing Formation Lansing

Phone (316) 267-4375

Elevation: Ground 2148' KB 2153'

Contractor: Name: Murfin Drilling Co.

Total Depth 3710' PBDT n/a


License: 6033

**PLEASE KEEP THIS
INFORMATION
CONFIDENTIAL**

Wellsite Geologist: Rocky Milford

KANSAS GEOLOGICAL SURVEY
WICHITA BRANCH
JAN 03 1990

Designate Type of Completion
 New Well Re-Entry Workover

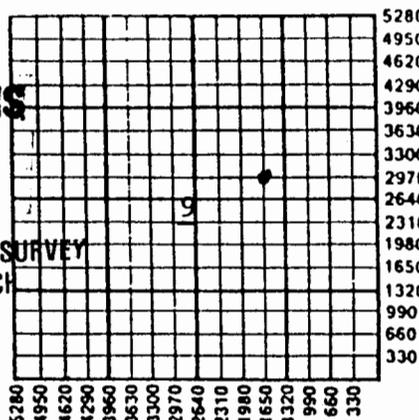

Oil SWD Temp. Abd.
 Gas Inj Delayed Comp.
 Dry Other (Core, Water Supply, etc.)

If OWO: old well info as follows:

Amount of Surface Pipe Set and Cemented at 220' Feet

Operator: _____

Well Name: _____

Multiple Stage Cementing Collar Used? Yes No

Comp. Date _____ Old Total Depth _____

If yes, show depth set 1800' Feet

Drilling Method:
 Mud Rotary Air Rotary Cable

If Alternate II completion, cement circulated from 1800'

9/18/89 9/25/89 11/01/89

feet depth to surface w/ 415 sx cmt.

Spud Date Date Reached TD Completion Date

INSTRUCTIONS: This form shall be completed in triplicate and filed with the Kansas Corporation Commission, 200 Colorado Derby Building, Wichita, Kansas 67202, within 120 days of the spud date of any well. Rule 82-3-130, 82-3-107 and 82-3-106 apply. Information on side two of this form will be held confidential for a period of 12 months if requested in writing and submitted with the form. See rule 82-3-107 for confidentiality in excess of 12 months. One copy of all wireline logs and drillers time log shall be attached with this form. ALL CEMENTING TICKETS MUST BE ATTACHED. Submit CP-4 form with all plugged wells. Submit CP-111 form with all temporarily abandoned wells. Any recompletion, workover or conversion of a well requires filing of ACO-2 within 120 days from commencement date of such work.

All requirements of the statutes, rules and regulations promulgated to regulate the oil and gas industry have been fully complied with and the statements herein are complete and correct to the best of my knowledge.

JAN 5 1990

Signature _____

Title President Date 12/28/89

Subscribed and sworn to before me this 28th day of December, 19 89.

Notary Public Linda K. Rice

LINDA K. RICE
NOTARY PUBLIC
STATE OF KANSAS
My Appl. Exp. 6-7-92

Date Commission Expires 6/07/92

K.C.C. OFFICE USE ONLY DIVISION
 Letter of Confidentiality Attached
 Wireline Log Received
 Drillers Timelog Received

Distribution
 KCC SWD/Rep NGPA
 KGS Plug Other (Specify)