


Section 21 Township 6 Range 29 W

Well No. # 1 Neff

Company Henderson Oil

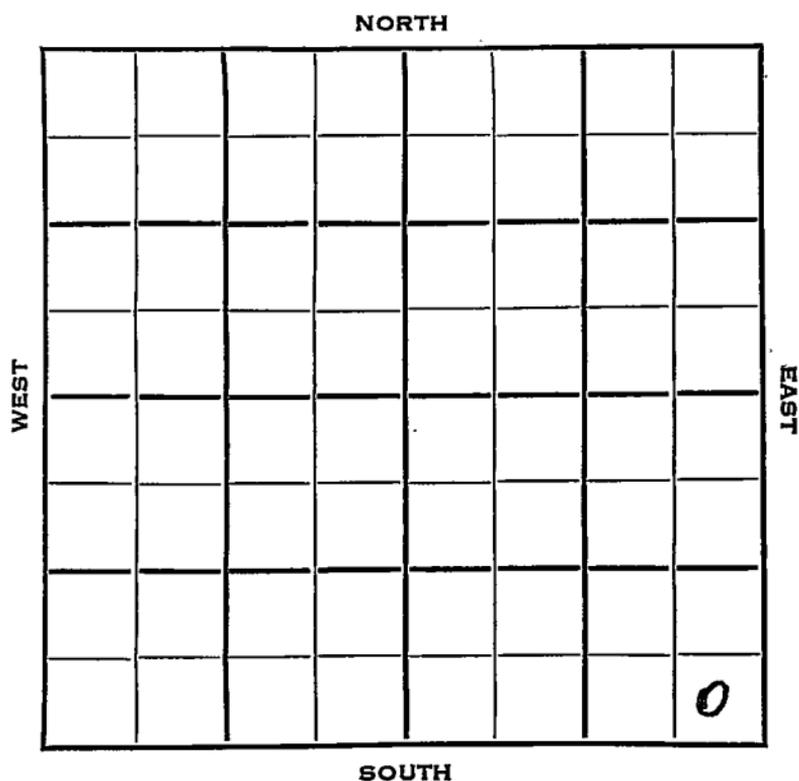

16

Sheridan

KANSAS

SEC.	TWP.	R.
21	6	29W ✓


WELL NO. #1 Neff FARM

COMPANY Henderson Oil

CONTRACTOR Bill Hay

Wessel Pool

\_\_\_\_\_ Ft. from N. Line  
 330 \_\_\_\_\_ Ft. from S. Line  
 330 \_\_\_\_\_ Ft. from E. Line  
 \_\_\_\_\_ Ft. from W. Line

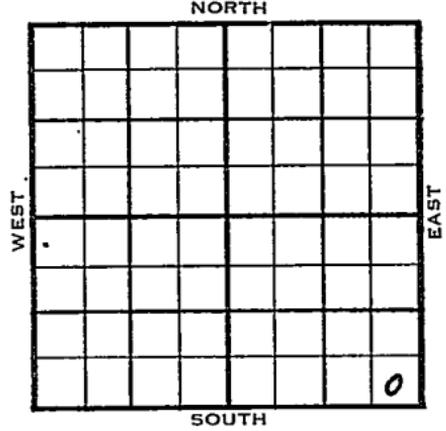

SE SE SE

	ELEVATION	REPORT
1953	2822'	
10/28	Spud 10-30-53	
11/4	8" @ 256 Drlg. 3250'	
11/11	Heeb 3905 Tor 3930 Lans 3947 RTD 4135 5" @ 4134	
11/18	CO 16/4115-16 NS 16/4087-88' NS Sq 19/4097-4103	
1954		
1/20	Spud 10-30-53 Oil well TD 4135 8" @ 256 Heeb 3905 Tor. 3930 Lans. 3947 TD 4135 5" @ 4134 16/4115-16 16/4087-88 19/4097-4103 1000 A S/6 BOPH Comp. 120 BOPD	

**COMPLETED**



