

Sheridan

DX 78-1

KANSAS

Section 21 Township 6 Range 29W

Well No. #1 Neff

Company Anderson, Plank & Arnao (Minneapolis Minn)

NORTH

							0

WEST

EAST

SOUTH

Sheridan KANSAS

SEC.	21	TWP.	6	R.	29 W
------	----	------	---	----	------

WELL NO. 1 Neff

COMPANY Anderson Plank & Arnao (Minneapolis FARM Minn.)


CONTRACTOR Bill Hay
Seldon Pool

330 Ft. from N. Line

Ft. from S. Line

330 Ft. from E. Line

Ft. from W. Line

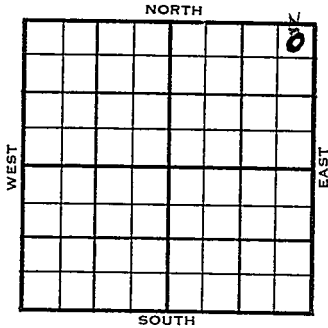

NE NE NE

1954	ELEVATION	REPORT
	2805'	

8-25 MIR
11/3 Spud 8-26-54
D & A
TD 4137'
8" @ 260'
Heeb 3894', Tor 3921', Lans 3936'
DST 3949'-90' opn 1 hr, rec 115' Mud 200#
DST 4066'-98' opn 1 hr, rec 28' ocm, 1 qt free oil 150#
TD 4137'
D & A

ABANDONED

