


Section 21 Township 6 Range 26 W

Well No. # 1 Glasgow

Company H. Gore

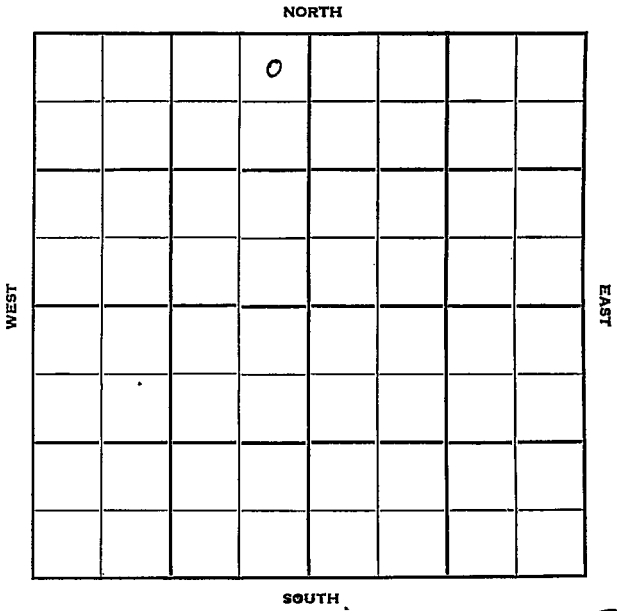

3

Sec. 21 Twp. 6 R. 26 W

Well No. # 1 Glasgow Farm

H. Gore Company

Empire Drlg.

Contractor

Wildcat

330 Ft. from N. Line


Ft. from S. Line

330 Ft. from E. Line

Ft. from W. Line

NE NE NW

Sun & Skelly - DHM

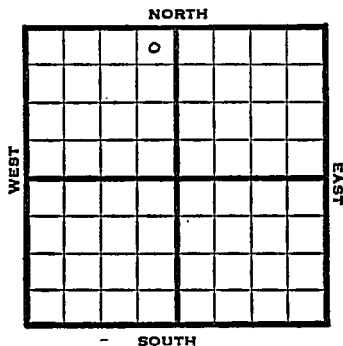

1951 Elev. 2645' REPORT

<p>9/19 11/7</p>	<p>Location</p> <p>Spud 10-19-51</p> <p>D&amp;A TD 4315</p> <p>8" @ 192</p> <p>Anhy 2275</p> <p>Heeb. 3735</p> <p>B KC 3970</p> <p>Viola 4245</p> <p>Arb. 4261</p> <p>TD 4315'</p> <p>D&amp;A</p>	<p>Top. 3576</p> <p>Lans. 3773</p> <p>Cong. 4190</p> <p>Simp. 4254</p>
----------------------	---	--

**ABANDONED**

County Sheridan State Kansas

Sec. 21 (Blk. Twp.) 6 (Sur. Rge.) 26W Map No.

Operator H. Gore

Well No. 1 Farm Glasgow

Elev. \_\_\_\_\_ Location NE NE NW

			0			

330 Ft. From N Line NW

330 Ft. From E Line Quarter

1st. Report SEP 19 1951

Completion \_\_\_\_\_

Remarks Sun & Skelly -DHM

Spudding Date \_\_\_\_\_

Drig. Data Wildcat

Location

J. E. TYRA

