

8-6-2206 *Ind*

STATE CORPORATION COMMISSION OF KANSAS
OIL & GAS CONSERVATION DIVISION
WELL COMPLETION OR RECOMPLETION FORM
ACO-1 WELL HISTORY

DESCRIPTION OF WELL AND LEASE

Operator: license # 6889
name Oxford Exploration Company
address 1801 California St. #200
Denver, CO 80202
City State Zip

Operator Contact Person David E. Park, Jr.
Phone (303) 572-3621

Contractor: license # 6033
name Murfin Drilling Company

Wellsite Geologist Dusty Rhoades
Phone (913) 743-5419

Designate Type of Completion

☒ New Well ☐ Re-Entry ☐ Workover

☐ Oil ☐ SWD ☐ Temp Abd
☐ Gas ☐ Inj ☐ Delayed Comp.
☐ Dry ☐ Other (Core, Water Supply etc.)

If OWWO: old well info as follows:

Operator
Well Name
Comp. Date Old Total Depth

WELL HISTORY

Drilling Method: ☒ Mud Rotary ☐ Air Rotary ☐ Cable

5/23/85.. 6/29/85.. 6/29/85..
Spud Date Date Reached TD Completion Date

4000'..
Total Depth PBD

Amount of Surface Pipe Set and Cemented at ... 303' .. feet

Multiple Stage Cementing Collar Used? ☐ Yes ☒ No

If Yes, Show Depth Set .. feet

If alternate 2 completion, cement circulated
from .. feet depth to .. w/ .. SX cmt

API NO. 15 - 065-22,202

County .. Graham ..

N/2 S/2 SE Sec 8 Twp 6S Rge 22 X We
(location)

990 Ft North from Southeast Corner of Section
1320 Ft West from Southeast Corner of Section
(Note: locate well in section plat below)


Lease Name .. Rouback .. Well# 8-15-1

Field Name ..

Producing Formation ..

Elevation: Ground ... 2301' .. KB ... 2306'

Section Plat

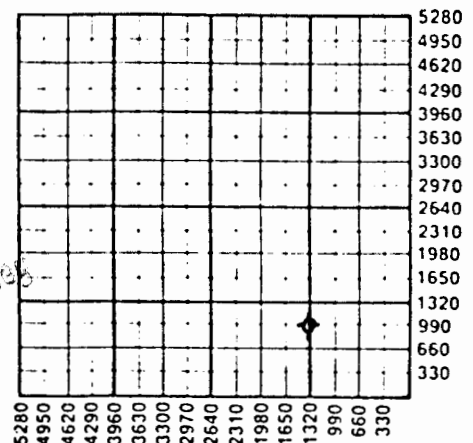

WATER SUPPLY INFORMATION

Source of Water:

Division of Water Resources Permit # ..

☐ Groundwater .. Ft North From Southeast Corner ar
(Well) .. Ft. West From Southeast Corner
Sec Twp Rge ☐ East ☐ West

☒ Surface Water ... 4950' .. Ft North From Southeast Corner ar
(Stream, Pond etc.) ... 330' .. Ft West From Southeast Corner
Sec 11 Twp 6S Rge 22 ☐ East ☒ West

☐ Other (explain) ..
(purchased from city, R.W.D.#)

Disposition of Produced Water: ☐ Disposal
☐ Repressuring

Docket # ..

INSTRUCTIONS: This form shall be completed in duplicate and filed with the Kansas Corporation Commission, 200 Colorado Derby Building, Wichita, Kansas 67202, within 90 days after completion or recompletion of any well. Rules 82-3-130 and 82-3-107 apply.

Information on side two of this form will be held confidential for a period of 12 months if requested in writing and submitted with the form. See rule 82-3-107 for confidentiality in excess of 12 months.

One copy of all wireline logs and drillers time log shall be attached with this form. Submit CP-4 form with all plugged wells. Submit CP-111 form with all temporarily abandoned wells.

AUG 15 1985
State Geological Survey
WICHITA BRANCH