


Section 22 Township 6 Range 29 W

Well No. # 2 Neff "A"

Company Westpan-Hydrocarbon

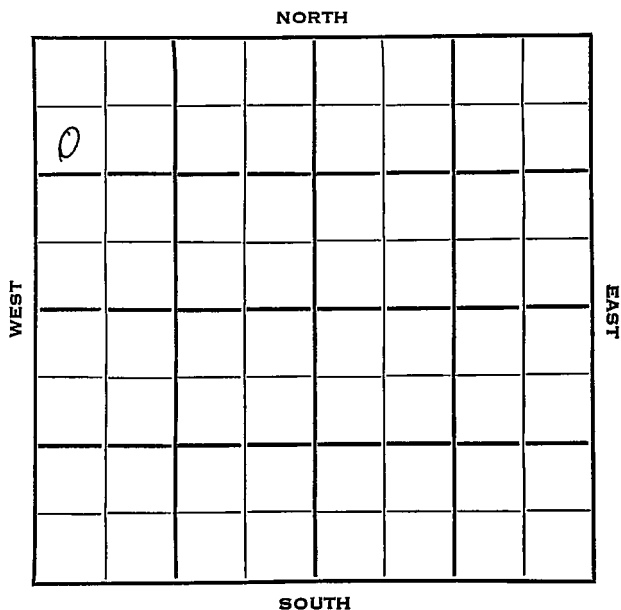

Sheridan

KANSAS

SEC.	TWP.	R.
22	6	29 W

WELL NO. # 2 Neff "A" . FARM

COMPANY Westpan-Hydrocarbon

CONTRACTOR Bill Hay

Wessell Pool


990 Ft. from N. Line

Ft. from S. Line

3 Ft. from E. Line

330 Ft. from W. Line

SW NW NW

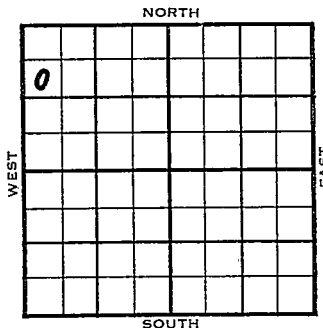

ELEVATION	REPORT
1953 2801'	

12/2 Cellar & Pits

12/9 8" @ 241
Drlg. 1130'

12/16 Heeb 3888', Lans 3931'

1954

~~Spud 12-3-53~~

5/19 Spud 12-3-53 D & A TD 4130
8" @ 241 Heeb 3888 Lans 3931
DST 3979-4010 open 1 hr rec 35' mud
1020# Winterset 4086 TD 4130
5" @ 4129 CO to 4114 3/4106-07
dry. 3/4078-79 dry CO to 4101
21/4088-95 2000 A PB 4086
3/4080-81 dry CO to 4101 2000 A
D & A

ABANDONED

