

Section 22 Township 6 Range 29 WWell No. # 1 Neff "A"Company Westpan-Hydrocarbon

NORTH

0							

SOUTH

EAST

WEST

4

Sheridan

SEC. 22	TWP. 6	R. KANSAS 29W ✓
---------	--------	-----------------

WELL NO. #1 Neff ^{"A"}~~"B"~~

COMPANY FARM

Westpan Hydrocarbon


CONTRACTOR

330 _____ Ft. from N. Line

_____ Ft. from S. Line

_____ Ft. from E. Line

330 _____ Ft. from W. Line

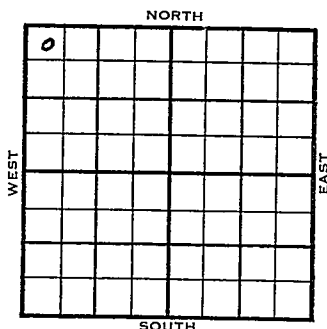

NW NW NW

1953	ELEVATION 2786'	REPORT
------	-----------------	--------

11/18 Spud 11-9-53
 8" @ 263'
 Dakota 1425', Anhy 2550'
 Drlg 3264'

1954
 5/19 Spud 11-9-53 Oil well TD 4113
 8" @ 263 Dakota 1425 Anhy 2550
 Heeb 3873 Lans 3916
 DST 3971-4000 open 1 hr rec 25' mud 0#
 DST 4074-90 open 1 hr rec 20' mud
 220# TD 4113 5" @ 4113
 0 to 4070 30/4069-73 1000 A
 Comp. 8 BOPD

COMPLETED

Kansas

Map No. _____ Sec. 22 Twp. 6 R. 29WWell No. 1 Neff "A"Westpan-Hydrocarbon

Company

CORRECTION

Contractor


NW NW NW

SECTION PLAT

330 Ft. from N. Line

_____ Ft. from S. Line

_____ Ft. from E. Line

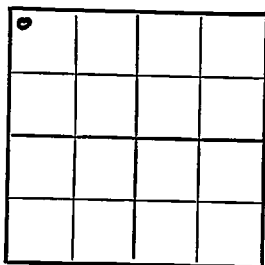330 Ft. from W. LineSheridan County

Location _____

Rig up _____

Drilling and Remarks:

Reported
#1 Neff "B"

RECORD

Cased _____ in., _____ ft.

Sand _____

Gas _____

Oil _____

Total Depth _____

PRODUCTION

1st 24 hrs. Nat. _____

1st 24 hrs. after shot _____

Gas _____ Cu. Ft.

Dry Hole _____

Abandoned _____

Date

NOV 24 1953J. G. McGEHEE Scout

County Sheridan State KansasSec. 22 (Blk. Twp.) 6 (Sur. Rge.) 29W Map No. -Operator Westpan-HydrocarbonWell No. 1 Farm Neff "B"Elev. Location NW NW NW

0					

330 Ft. From N Line NW330 Ft. From W Line Quarter1st. Report NOV 18 1953Completion Remarks Spudding Date 11-9-53Drlg. Data 8" @ 263 Dakota 1425 Anhy 2550drlg. 3264

County Sheridan State Kansas
 Sec. 22 (Blk. 6) (Sur. 29W) Map No.
 Operator Westpan-Hydrocarbon
 Well No. 1 Farm Neff "A"
 Elev. 2786 Location NW NW NW

0									

330 Ft. From N Line NW
 330 Ft. From W Line Quarter

1st. Report

Completion MAY 19 1954

Remarks Wessell Pool

Spudding Date 11-9-53

Drlg. Data Oil well TD 4113

8" @ 263 Dakota 1425 Anhy 2550

Heeb. 3873 Lans. 3916 DST 3971-4000

open 1 hr. Rec. 25' mud 0#

DST 4074-90 open 1 hr. Rec. 20' mud

220# TD 4113 5" @ 4113 CO to 4070

30/ 4069-73 1000 A Comp. 8 bopd

J. G. McGEHEE