

DX 78-1


Sheridan

KANSAS

Section 22 Township 6 Range 26W

Well No. #1 Shower

Company W. W. Sauvage

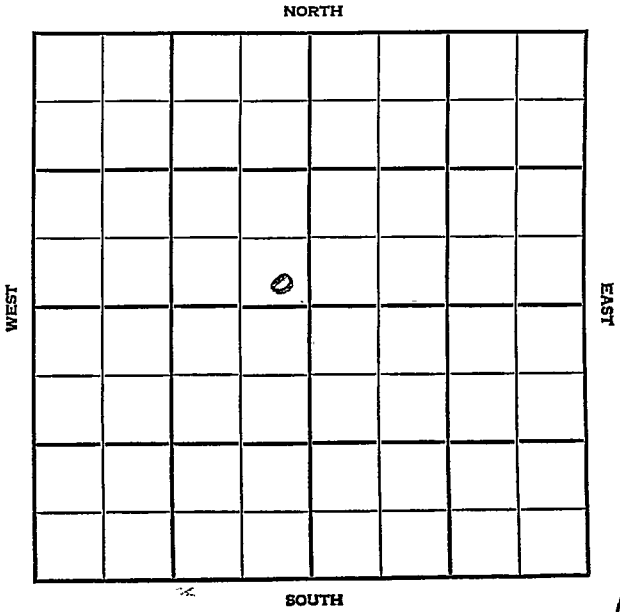

# LOT FILE Sheridan

SECT	TWP.	R.
22	6	26 W


WELL NO. # 1 Shower FARM

COMPANY W. W. Sauvage

CONTRACTOR

Wildcat

\_\_\_\_\_ Ft. from N. Line  
 \_\_\_\_\_ Ft. from S. Line  
 \_\_\_\_\_ Ft. from E. Line  
 \_\_\_\_\_ Ft. from W. Line

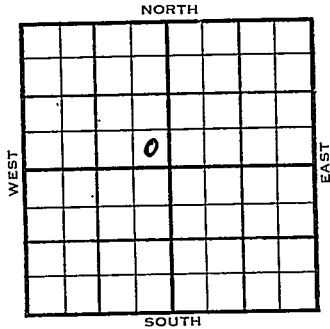

SE SE NW

1/2 Mile - SDX  
 Sohio - DHM

1955	ELEVATION	REPORT
		Arb. Test
6/15	MIR	
6/23	Spud 6-14-55 8-5/8" @ 320/150 Drlg. 3423'	
6/30	Heeb. 3720, Lans. 3760, B.KC. 3967, Cong. 4202, TH. 4256, D&A holding for log tops.	
7/22	D&A	
	Tops:	Depth Log Datum
	H.	3720 3719 1084
	Tr.	3741 1106
	L.	3760 3758 1123
	BKC	3967 3960 1325
	C.	4202 4199 1564
	A.	4230 1595
	TD	4256 4258

**ABANDONED**

County Sheridan ✓ Elev. \_\_\_\_\_  
 Sec. 22 Twp. 6 Rge. 26W  
 Company W. W. Sauvage  
 FarmName Shower No. 1

Co.

TOPS	DEPTH	LOG	DATUM
Anh.			
Tp.			
H.			
Tr.			
Dg.			
Bl.			
L.			
K.C.			
B.K.C.			
Ce.			
C.			
M.			
M.			
K.			
Mz.			
Mq.			
V.			
S.			
S.			
A.			
R.			
PE.			
G.			
T.D.			

Loc. in Sec. \_\_\_\_\_  
SE SE NW  
Arb. test  
 Geol. \_\_\_\_\_  
 Contr. \_\_\_\_\_  
 Pool \_\_\_\_\_  
Wildcat  
 FIRST REPORT  
 1/2 Mile  
 JUN 5 1954  
 SDX

Lse.

No.

Sec.

T.

R.

Date Comm. Sohio DFM  
M I R

K-3

County Sheridan Elev. 2635  
 Sec. 22 Twp. 6 Rge. 26W  
 Company W. W. Sauvage  
 Farm Name Shower No. 1

Co.

TOPS	DEPTH	LOG	DATUM
Anh.			
Tr.			
H.	3720	3719	1084
Tr.		3741	1106
Dg.			
Bl.			
L.	3760	3758	1123
K.C.			
B.K.C.	3967	3960	1325
Ce.			
C.	4202	4199	1564
M.			
M.			
K.			
Mz.			
Me.			
V.			
S.			
S.			
A.		4230	1595
R.			
PE.			
G.			
TD.	4256	4258	

Loc. in Sec. SE SE NW

Geol.

Contr.

Pool

Wildcat

	0		
ABANDONED			

Loc.

No.

Date Comm. 6-14-55  
8 5/8" @ 320/150

**JUL 6 1955**

D & A

Sec.

T.

R.