

SIDE ONE

STATE CORPORATION COMMISSION OF KANSAS
OIL & GAS CONSERVATION DIVISION
WELL COMPLETION OR RECOMPLETION FORM
ACO-1 WELL HISTORY
DESCRIPTION OF WELL AND LEASE

API NO. 15-.....065-22,494.....
County.....Graham.....
160' E & 20' S of East
.....NW SE SW..... Sec. 1... Twp. 6S... Rge. 23W, X West

Operator: License # ...4767.....
Name ..Ritchie Exploration, Inc.....
Address ..125 N. Market, Suite 1000.....
City/State/Zip ...Wichita, KS 67202.....

.....970..... Ft North from Southeast Corner of Section
.....3470..... Ft West from Southeast Corner of Section
(Note: Locate well in section plat below)

Purchaser.....Koch Oil Company.....
.....Wichita, KS.....

Lease Name.....John Kemper.....Well #1.....

Operator Contact Person ..Jeff Christian.....
Phone316/267-4375.....

Field Name.....

Producing Formation.....Lansing.....

Contractor: License #6033.....
NameMurfin Drilling Co.....

Elevation: Ground.....2331'.....KB.....2336'.....

Wellsite Geologist...Jeff Christian.....
Phone.....316/267-4375.....

Designate Type of Completion
 New Well Re-Entry Workover

Oil SWD Temp Abd
 Gas Inj Delayed Comp.
 Dry Other (Core, Water Supply etc.)

If OWNED: old well info as follows:
Operator
Well Name
Comp. DateOld Total Depth.....

Drilling Method:
 Mud Rotary Air Rotary Cable
10/17/88 10/22/88 11/11/88
Spud Date Date Reached TD Completion Date
3786' N/A
Total Depth PBDT

Amount of Surface Pipe Set and Cemented at 258' feet
Multiple Stage Cementing Collar Used? Yes No
If yes, show depth set..1942.....feet
If alternate 2 completion, cement circulated
from...1942'...feet depth to...surface 500...SX cmt
Cement Company Name...Allied Cementing Co.....
Invoice # 52764.....

INSTRUCTIONS: This form shall be completed in triplicate and filed with the Kansas Corporation Commission, 200 Colorado Derby Building, Wichita, Kansas 67202, within 120 days of the spud date of any well. Rule 82-3-130, 82-3-107 and 82-3-106 apply. Information on side two of this form will be held confidential for a period of 12 months if requested in writing and submitted with the form. See rule 82-3-107 for confidentiality in excess of 12 months. One copy of all wireline logs and drillers time log shall be attached with this form. Submit CP-4 form with all plugged wells. Submit CP-111 form with all temporarily abandoned wells.

All requirements of the statutes, rules and regulations promulgated to regulate the oil and gas industry have been fully complied with and the statements herein are complete and correct to the best of my knowledge.

Signature
Title.....Vice President.....
KANSAS GEOLOGICAL SURVEY
WICHITA BRANCH
Subscribed and sworn to before me this 6th day of February 1989.
Notary Public...Linda K. Rice.....
Date Commission Expires.....6/07/92.....

LINDA K. RICE
NOTARY PUBLIC
STATE OF KANSAS
My Appt. Exp. 6-7-92

.....970..... Ft North from Southeast Corner of Section
.....3470..... Ft West from Southeast Corner of Section
(Note: Locate well in section plat below)


Lease Name.....John Kemper.....Well #1.....

Field Name.....

Producing Formation.....Lansing.....

Elevation: Ground.....2331'.....KB.....2336'.....

Section Plat

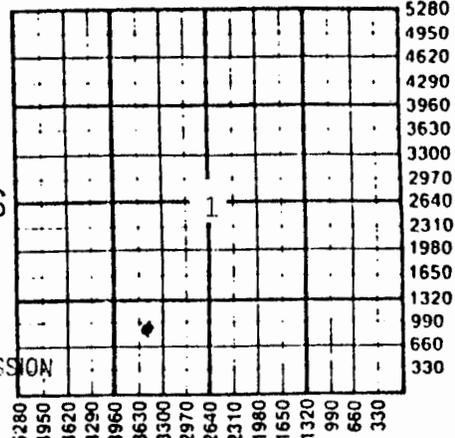

Disposition of Produced Water: Disposal
Docket # 25,041 Repressuring

Questions on this portion of the ACO-1 call:
Water Resources Board (913) 296-3717
Source of Water: Water well.
Division of Water Resources Permit #.....
Groundwater.....Ft North from Southeast Corner
(Well)Ft West from Southeast Corner of
Sec Twp Rge East West
Surface Water.....Ft North from Southeast Corner
(Stream, pond etc).....Ft West from Southeast Corner
Sec Twp Rge East West
Other (explain).....
(purchased from city, R.W.D. #)

K.C.C. OFFICE USE ONLY
 Letter of Confidentiality Attached
 Wireline Log Received
 Drillers Time Log Received
Distribution
 KCC SWD/Rep NGPA
 KGS Plug Other
(Specify)