SIDE ONE

9-6-23W

STATE CORPORATION COMMISSION OF KANSAS
OIL & GAS CONSERVATION DIVISION
WELL COMPLETION OR RECOMPLETION FORM
ACO-1 WELL HISTORY
DESCRIPTION OF WELL AND LEASE

API NO. 15- 065-22,481

County: Graham

SW. NW. NW. Sec. 9 Twp. 6S Rge. 23W X East West

4290 Ft North from Southeast Corner of Section
4950 Ft West from Southeast Corner of Section
(Note: Locate well in section plat below)

Lease Name: Schuck-9B Well #: 1

Field Name:

Producing Formation: Lansing

Elevation: Ground: 2423' KB: 2428'

Operator: License #: 4767
Name: Ritchie Exploration, Inc.
Address: 125 N. Market, Suite 1000
City/State/Zip: Wichita, KS 67202

Purchaser: Koch Oil Co.
Wichita, KS

Operator Contact Person: Rocky Milford
Phone: 316/267-4375

Contractor: License #: 6033
Name: Murfin Drilling Co.

Wellsite Geologist: Jeff Christian
Phone: 316/267-4375

PLEASE KEEP THIS INFORMATION CONFIDENTIAL

Section Plat

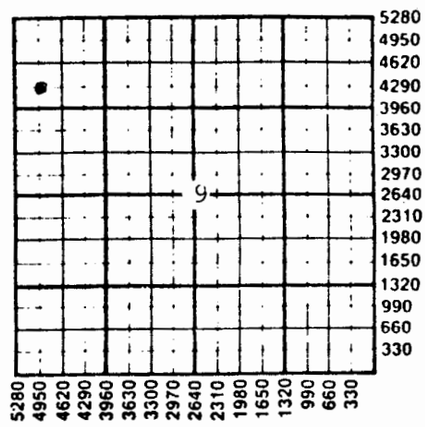

Designate Type of Completion
X New Well ___ Re-Entry ___ Workover

X Oil ___ SWD ___ Temp Abd
___ Gas ___ Inj ___ Delayed Comp.
___ Dry ___ Other (Core, Water Supply etc.)

If OWWO: old well info as follows:
Operator:
Well Name:
Comp. Date: Old Total Depth:

WELL HISTORY

Drilling Method:
X Mud Rotary ___ Air Rotary ___ Cable

8/8/88	8/16/88	11/30/88
Spud Date	Date Reached TD	Completion Date

3845'	n/a
Total Depth	PBTD

Amount of Surface Pipe Set and Cemented at 250 feet
Multiple Stage Cementing Collar Used? X Yes ___ No
If yes, show depth set 2009' feet
If alternate 2 completion, cement circulated from 2009' feet depth to surface w/ 550 SX cmt
Cement Company Name: Allied Cementing Co.
Invoice #: 52526

WATER SUPPLY INFORMATION
Disposition of Produced Water: XX Disposal
Docket #: D-24,228 ___ Repressuring

Questions on this portion of the ACO-1 call:
Water Resources Board (913) 296-3717
Source of Water: Hauled.
Division of Water Resources Permit #:

___ Groundwater: Ft North from Southeast Corner
(Well): Ft West from Southeast Corner of
Sec Twp Rge ___ East ___ West

___ Surface Water: Ft North from Southeast Corner
(Stream, pond etc): Ft West from Southeast Corner
Sec Twp Rge ___ East ___ West

___ Other (explain):
(purchased from city, R.W.D. #)

INSTRUCTIONS: This form shall be completed in triplicate and filed with the Kansas Corporation Commission, 200 Colorado Derby Building, Wichita, Kansas 67202, within 120 days of the spud date of any well. Rule 82-3-130, 82-3-107 and 82-3-106 apply.
Information on side two of this form will be held confidential for a period of 12 months if requested in writing and submitted with the form. See rule 82-3-107 for confidentiality in excess of 12 months.
One copy of all wireline logs and drillers time log shall be attached with this form. Submit CP-4 form with all plugged wells. Submit CP-111 form with all temporarily abandoned wells.

All requirements of the statutes, rules and regulations promulgated to regulate the oil and gas industry have been fully complied with and the statements herein are complete and correct to the best of my knowledge.

Signature: [signature]
Title: Vice President Date: 11/29/88

DEC 06 1988

Subscribed and sworn to before me this 29th day of November 19.88
Notary Public: Linda K. Rice
Date Commission Expires: 6-7-92

LINDA K. RICE
NOTARY PUBLIC
STATE OF KANSAS
My Appt. Exp. 6-7-92

K.C.C. OFFICE USE ONLY
F ✓ Letter of Confidentiality Attached
C ✓ Wireline Log Received
C ___ Drillers Timelog Received
Distribution
KCC ___ SWD/Rep ___ NGPA
KGS ___ Plug ___ Other (Specify)

RECEIVED
STATE CORPORATION COMMISSION

Sec. 9 Twp. 6 Rge. 23W

Form ACO-1 (5-86)

CONSERVATION DIVISION
Wichita, Kansas

KANSAS GEOLOGICAL SURVEY