
FORM 51 25M 8-50 WESTERN Graham KANSAS

Section 24 Township 6 Range 23 W

Well No. #1 Oliver

Company Wood River

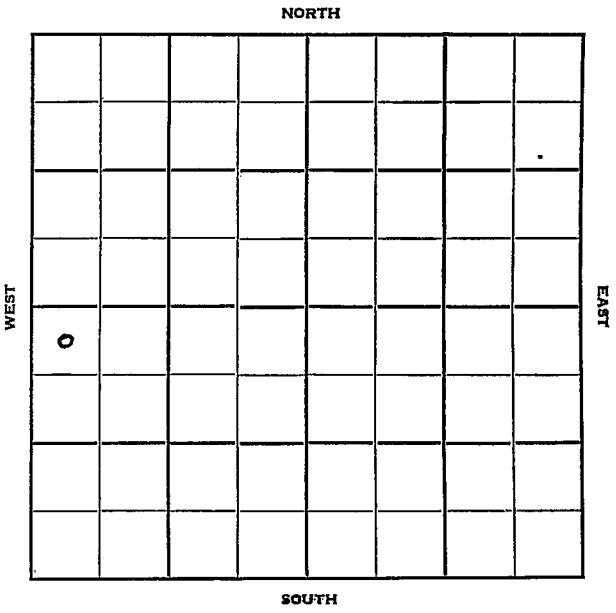

12

FORM 252-B
10M 11-50 PETROL

HOT FILE

Graham County KANSAS ✓

Sec. 24 Twp. 6S R. 23W

Well No. #1 Oliver (A.E. Thompson) Farm

Woodriver Oil & Refg. Inc. Company

Contractor

MCPC donating $2000.00 dry hole money


330 Ft. from N. Line

Ft. from S. Line

Ft. from E. Line

330 Ft. from W. Line

NW NW SW

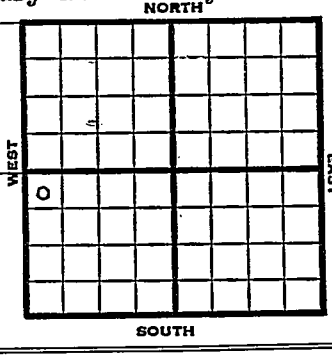

1951	Elev. 2409' REPORT
	4000' Arbuckle lime test
1/30	To start by March 15, 1951 To comp. by May 15, 1951.
2/2	Moving in tools today on the above test. (L R)
2/5	TD. 257' Starting to run 8-5/8" surface casing. "
2/6	8-5/8" at 255' WOC. "
2/7	Drilling 870'. "
2/8	Drilling 1975'. "
2/9	Drilling 2505'. "
2/10	Drilling 2945'. "
2/12	Drilling 3300' Expect Kansas City at 3600'. "
2/13	Drilling 3585' Expect Kansas City at 3640'. "
2/14	Top Kansas City 3632' (-1221) some staining and odor DST. 3638'-44' Open 1 hr. Got 610' salt water, no oil BHP. 1100#. "
2/15	Drilling 3693' Set packer 3672' DST. 3678'-91' Got 450' salt water Est. Arbuckle 3900'-3950'. "
2/16	Drilling 3815'. "
2/17	Drilling 3930', no Arbuckle as yet. "

1951

2/18 Arbuckle 3964' (-1565')
Have some porosity, no stain
Drilled to 4005'
D & A.

2/21 Spudded 2-5-51
D & A TD 4005'
8-5/8" @257
KC 3632
DST 3638-44 open 1 hr. rec. 610' sw
SP 3672
DST 3678-91 open 1 hr. rec. 450' sw
Arb. 3975 TD 4005
D & A

ABANDONED

3959
4005
5616

FORM 275 FOR SALE BY KANSAS BLUE PRINT CO.


County Graham State Kansas

Sec. 24 (Blk. Twp.) 6 (Sur. Rge.) 23W Map No.

Operator Wood River

Well No. 1 Farm Oliver

Elev. Location NW NW SW

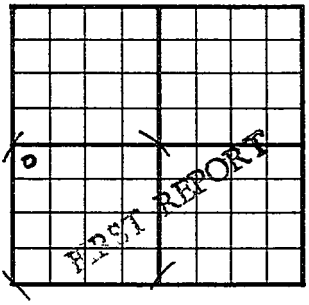

330 Ft. From N Line SW

330 Ft. From W Line Quarter

1st. Report JAN 17 1951

Completion

Remarks Magnolia DHM

MCPC owns NW of 23.
Giving $2000.00 DHM

Spudding Date

Drlg. Data Wildcat

Location

J. E. TYRA

FORM 275 FOR SALE BY KANSAS BLUE PRINT CO.


County Graham State Kansas

Sec. 24 (Blk. Twp.) 6 (Sur. Rge.) 23W Map No.

Operator Wood River

Well No. 1 Farm Oliver

Elev. 2409 Location NW NW SW

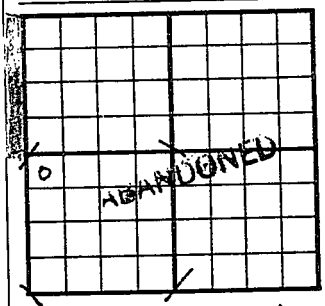

330 Ft. From N Line SW

330 Ft. From W Line Quarter

1st. Report

Completion FEB 21 1951

Remarks Wildcat

Spudding Date 2-5-51

Drlg. Data D & A TD 4005

8 5/8" @ 257 KC 3632 DST 3638-44

open 1 hr. Rec. 610' sw SP 3672

DST 3678-91 open 1 hr. Rec. 450' sw

Arb. 3975 TD 4005

D & A

J. E. TYRA