

KANSAS


Sheridan County

FORM 51 5M BR1X

Section 24 Township 6 Range 26W

Well No. #1, Vahling 15 Strat

Company Continental Oil

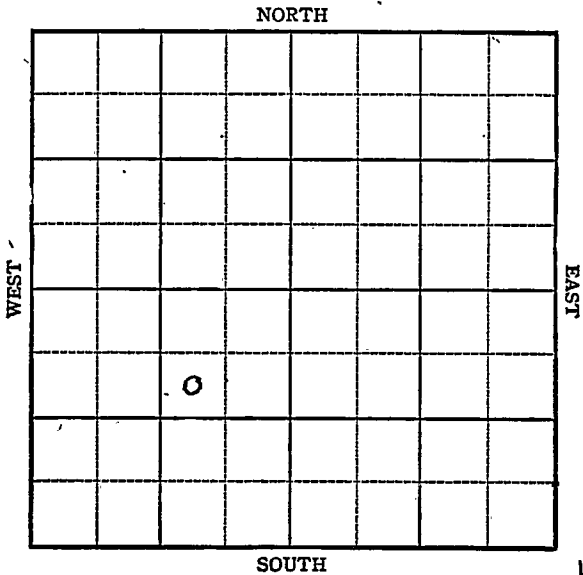

Sec. 24 Twp. 6 R. 26W

Well No. #1 Bahling 15 Strat Farm

Continental Company


Wildcat

990 Ft. from N. Line

 Ft. from S. Line

990 Ft. from E. Line

 Ft. from W. Line

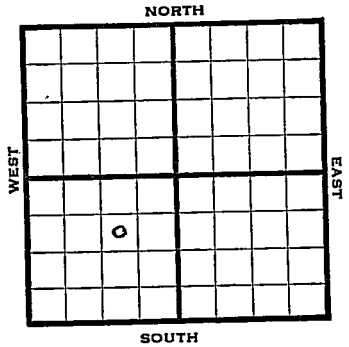

SW NE SW

REPORT

1944

8/16

Anhy2128

Lans 3727

Stains 3733--40 37 60-63, 3835-40

Arb 4083

Granite Wash 4239

TD 4269

~~D & A~~
FIRST REPORT

ABANDONED

Pool Name Wildcat

Map No. 133 ^{KANSAS} Sec. 24 Twp. 6 R. 26W

Well No. 1 Bahling 15 Strat

Continental Company

FIRST REPORT

Contractor _____

SW NE SW ABANDONED SECTION PLAT

990 Ft. from N. Line

_____ Ft. from S. Line

990 Ft. from E. Line

_____ Ft. from W. Line

Sheridan

Location _____

Rig up _____

Drilling and Remarks:

Anh 2128
 Lans 3727
 Stains 3733-40
 3760-63, 3835-40
 Abb 4083
 Granite Wash
 4239
 D & A

RECORD

Cased _____ in, _____ ft.

Sand _____

Gas _____

Oil _____

Total Depth 4265

PRODUCTION

1st 24 hrs. Nat. _____

1st 24 hrs. after shot _____

Gas _____ Cu. Ft.

Dry Hole _____

Abandoned _____

Date

AUG 16 1944 19

S. J. LEWIS

Scout