
FORM 51 25M 8-50 WESTERN Sheridan KANSAS

Section 25 Township 6 Range 30 W

Well No. # 1 Wyant

Company Anschutz

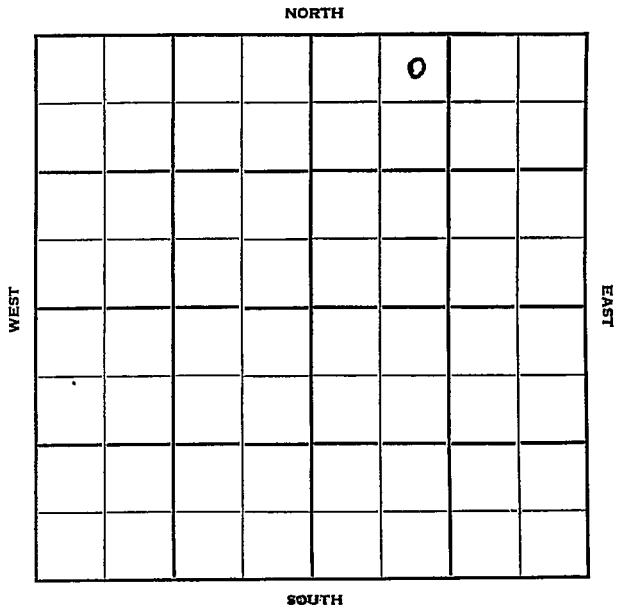

2

FORM 252-B
10M 10-50 PETROL

Sheridan

KANSAS

Sec. 25 Twp. 6 R. 30W

Well No. #1 Wyant Farm

Anschuts Company

~~Wildcat~~ Contractor


330 Ft. from N. Line

Ft. from S. Line

Ft. from E. Line

990 Ft. from W. Line

NE NW NE

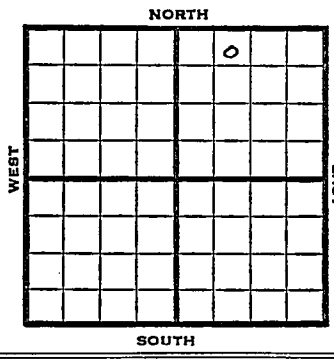

1952	Elev. 2893 REPORT
8/20	MIR
8/27	8" @ 252 Drlg. 2900'
9/3	Anhy 2595 Howard 3651 Topeka 3719 Heeb. 3953 Lans. 3996 B KC 4219 DST 3689-3703, 1 hr. 75' SOCM 1020# DST 3998-4071, 1 hr. 1035' SW 1330# DST 4153-61, 1 hr. 63' SW 1150# Drlg.
9/10	Spud 8-19-52 D&A TD 4585 8" @ 252 Anhy 2595 Howard 3651 Top. 3719 Heeb. 3953 Lans. 3996 BKC 4219 DST 3689-3703 opn 1 hr. Rec. 75' socm 1020# DST 3998-4071 opn 1 hr. Rec. 1035' sw 1330# DST 4153-61 opn 1 hr. Rec. 62' sw 1150# DST 4368-4407 opn 1 hr. Rec. 1' oil 120' socm Miss 4466 Miss dol. 4572 TD 4585 D&A ABANDONED

FORM 275 FOR SALE BY KANSAS BLUE PRINT CO.


County Sheridan State Kansas

Sec. 25 (Blk. Twp.) 6 (Sur. Rge.) 30W Map No.

Operator Anschutz

Well No. 1 Farm Ryant

Elev. Location NE NW NE

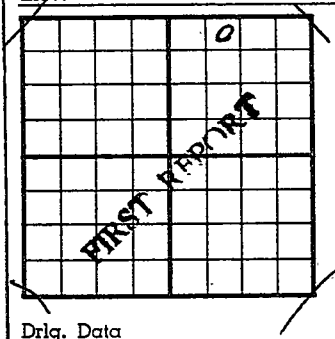

330 Ft. From N Line NE

990 Ft. From W Line Quarter

1st. Report AUG. 20 1952

Completion

Remarks

Spudding Date

Drlg. Data Wildcat

MIR

J. G. McGEHEE

FORM 275 FOR SALE BY KANSAS BLUE PRINT CO.


County Sheridan State Kansas

Sec. 25 (Blk. Twp.) 6 (Sur. Rge.) 30W Map No.

Operator Anschutz Drlg.

Well No. 1 Farm Wyant

Elev. 2893 Location NE NW NE

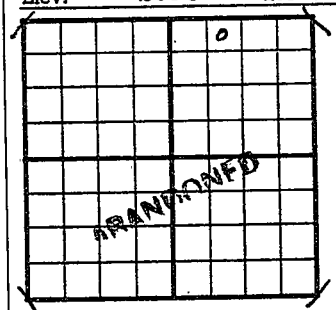

330 Ft. From N Line NE

990 Ft. From W Line Quarter

1st. Report

Completion SEP 1 0 1952

Remarks Wildcat

Spudding Date 8-19-52

Drlg. Data D & A TD 4585

8" @ 252 Anhy 2595 Howard 3651

Top. 3719 Heeb. 3953 Lans. 3996

B KC 4219 DST 3689-3703 open 1 hr.

Rec. 75' socm 1020# DST 3998-4071

open 1 hr. Rec. 1035' sw 1330#

DST 4153-61 open 1 hr. Rec. 62' sw

1150# DST 4368-4407 open 1 hr.

Rec. 1' oil 120' socm Miss. 4466

Mids. dol. 4572 TD 4585

D & A

J. G. McGEHEE