

Section 25 Township 6 Range 22WWell No. #1 ThurlowCompany Harry Gore et al.

Wildcat

NORTH

WEST

EAST

							0

SOUTH

KANSAS
KANSAS

Graham



Sec. 25 Twp. 6 R. 22W

Well No. #1 Thurlow Farm
Harry Gore et al Company
Wildcat


330 Ft. from N. Line

 Ft. from S. Line

330 Ft. from E. Line

 Ft. from W. Line

NE/C

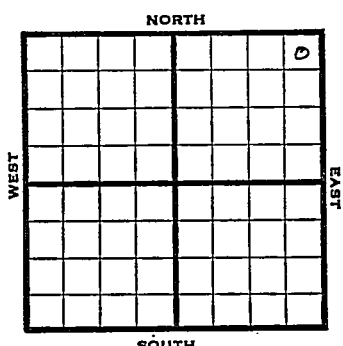

1948 Elev. 2254' REPORT

4/7 Location
4/14 RUR
4/21 8" @ 185'
Drlg. 3459'
4/28 Lens. 3496'
Cong. 3264'
Granite Wash 3865'
Granite 3904'
TD 3910'
ABANDONED

Map No. _____ Sec. 25 Twp. 6 R. 22W


Well No. 1 Thurlow

Harry Gore et al. Company

FIRST REPORT Contractor

NE/C

SECTION PLAT

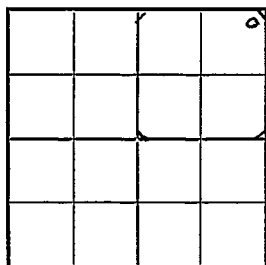

330 Ft. from N. Line

_____ Ft. from S. Line

330 Ft. from E. Line

_____ Ft. from W. Line

Graham County

Location X

Rig up _____

Drilling and Remarks:

RECORD

Cased _____ in., _____ ft.

Sand _____

Gas _____

Oil _____

Total Depth _____

PRODUCTION

1st 24 hrs. Nat. _____

1st 24 hrs. after shot _____

Gas _____ Cu. Ft.

Dry Hole _____

Abandoned _____

Date

APR 7 1948

19

S. J. LEWIS Scout

Wildcat

Form 26—200 Bks.—1-48—Palace
KansasMap No. 134 Sec. 25 Twp. 6 R. 22WWell No. 1 ThurlowHarry Gore et al. Company**ABANDONED**

Contractor

NE/C

E 1,2254
SECTION PLAT330 Ft. from N. Line2 Ft. from S. Line330 Ft. from E. Line Ft. from W. Line

			o

Graham CountyLocation Rig up

Drilling and Remarks:

Loss 3496Loss 3264Granite Wash 3865Granite 3904

RECORD

Cased in., ft.Sand Gas Oil Total Depth 3910

PRODUCTION

1st 24 hrs. Nat. 1st 24 hrs. after shot Gas Cu. Ft.Dry Hole Abandoned

Date

APR 28 1948 19 S. J. LEWIS Scout