


Section 25 Township 6 Range 26 W

Well No. #1 Wente

Company Jones, Shelburne & Farmer

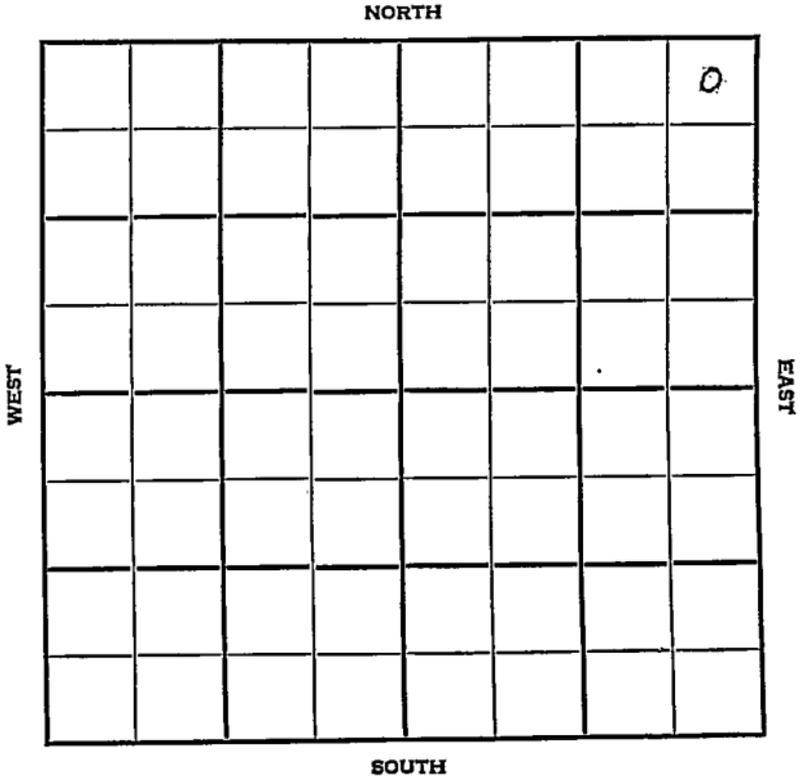

Sheridan

KANSAS

SEC. 25	TWP. 6S	R.. 26W
------------	------------	------------

WELL NO.

#1 Wente

FARM

COMPANY

Jones, Shelburne & Farmer

CONTRACTOR


Allodium

_____ Ft. from N. Line

_____ Ft. from S. Line

_____ Ft. from E. Line

_____ Ft. from W. Line

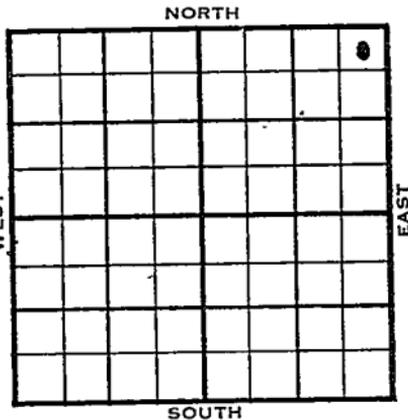

NE NE NE

	ELEVATION	REPORT
1955:	2605	

8/20

C&P

8/10

Comm 7-23-55

Anx 2177

H 3650

Tr ~~3673~~ 3673

L 3691

BKC 3881

TD 3885

8 5/8" @ 328 w/135

DST 3742-62 1 hr gd glo 1 hr

295' MSW 800/20" DST 3768-75 1 hr wk

glo 45" 10' M 990/20"

D & A

ABANDONED

County Sheridan Elev. _____
 Sec. 25 Twp. 6S Rge. 26W
 Company Jones, Shelburne & Farmer
 Farm Name Wente No. 1

Co.

TOPS	DEPTH	LOG	DATUM
Anh.			
Tp.			
H.			
Tr.			
Dg.			
Bl.			
L.			
K.C.			
B.K.C.			
Ce.			
C.			
M.			
M.			
K.			
Mz.			
Mo.			
V.			
S.			
S.			
A.			
R.			
Pe.			
G.			
T.D.			

Loc. in Sec. NE NE NE

Geol. _____

Contr. _____

Pool Allodium

		6
JUL 28 55		
FIRST REPORT		

Lse.

No.

Sec.

T.

R.

Date Comm. G & P.

55

County Sheridan Elev. 2605
 Sec. 25 Twp. 6 Rge. 26W
 Company J-S-F
 Farm Name Wente No. 1

Co.

TOPS	DEPTH	LOG	DATUM
Anh.	<u>2177</u>		
TP.			
H.	<u>3650</u>		<u>1045</u>
Tr.	<u>3673</u>		<u>1068</u>
Dg.			
BL.			
L.	<u>3691</u>		<u>1086</u>
K.C.			
B.K.C.	<u>3881</u>		<u>1276</u>
Ce.			
C.			
M.			
M.			
K.			
Mz.			
Me.			
V.			
S.			
S.			
A.			
R.			
Pe.			
G.			
TD.	<u>3885</u>		

Loc. in Sec. NE NE NE

Geol.

Contr.

Pool

Allodium

		<u>0</u>
<u>AUG</u>	<u>10</u>	<u>195</u>
ABANDONED		

Loc.

No.

Sec.

T.

R.

Date Comm. 7/23/55 8 5/8" 328 w/135 DST 3742-

62 1 hr gd glo 1 hr 295' MSW 800/20"

DST 3768-75 1 hr wk glo 45" 10' M 990/20"

D & A