

Sheridan KANSAS

Section 27 Township 6 Range 29 WWell No. # 1 WessellCompany Westpen Hydro-Carbon

0							

NORTH

WEST

EAST

SOUTH

4

Sheridan

KANSAS ✓


Sec. 27 Twp. 6 R. 29WWell No. #1 Wessel FarmWestpan Hydro-Carbon CompanyGlenn Peel ContractorWildcat990 Ft. from N. Line

Ft. from S. Line

Ft. from E. Line

330 Ft. from W. Line

SW NW NW

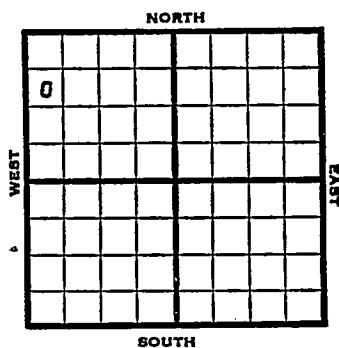

1952

Elev. 2818'

REPORT

12/3 Location

12/11 Ø3062

12/18Ø Tite Hole

12/25 Coring Tite Hole

1/1 Topeka 3627 Heeb 3901 Tor 3928, Lans
 3944 DST 4005-28 20 Min. 570' oil 40'
 M 1290# BKC 4153 Miss Chery 4448 Miss
 L 4602 RTD 4720 5" @ 4155

1/8 NR

1/15 "

1/22 NR

1/29 Testing

2/5 "

2/12 NR

2/19 NR

2/26 P/60 BOPD plus trace

3/11 Spud 12-4-52

Oil well TD 4720' 8" @ 290

Anhy 2170' Top. 3627' Heeb 3901'

Tor. 3928' Lans. 3944'

DST 4005-28, open 20 min, rec 570' oil
 40' mud. 1290# B KC 4153' Miss

ch. 4448' Miss. lime 4499'

Dol. 4507-79' Arb. 4602'

TD 4720' 5" @ 4155

OVER

1953

3/11

(Information continued)

DST 4087-97, open 1 hr, rec 6' mud,
oil specks 0#-

DST 4452-80 open 1 hr. rec 40' mud &
wtr. 985#

DST 4513-41, open $\frac{1}{2}$ hr. rec 2565' sul
& SW. 1200#

DST 4628-35 open $\frac{1}{4}$ hr. rec 180' SW
1270# CO to 4110 12/4092-96

S/21 GM 500 A S/7 BO 7 hr.

1500 A

S/145 BO 5 hr & SW SP 4071'


24/4023-31' FU 1600' fluid 21/3985-93

S/430 BO CO to 4020 $\frac{1}{2}$ 64/4002-18

S/32 GOPH 3 hr. 500 A S/13.8 BOPH
5 hr. P/60 BOPD

Comp. 216 BOPD

COMPLETED

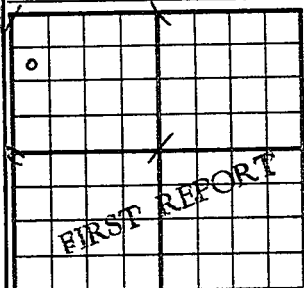County Sheridan State KansasSec. 27 (Blk. Twp.) 6 (Sur. Rge.) 29W Map No.Operator Westpan Hydro-CarbonWell No. 1 Farm WesselElev. Location SW NW NW990 Ft. From N Line NW330 Ft. From W Line Quarter1st. Report DEC 3 1952

Completion

Remarks


Gleem Peel - Contr.

Spudding Date

Drlg. Data WildcatLocation

J. G. McGEHEE

County Sheridan State Kansas
 Sec. 27 (Blk.) 6 (Sur.) 29W Map No.
 Operator Westpan Hydro-Carbn
 Well No. 1 Farm Wessel
 Elev. 2818 Location SW NW NW

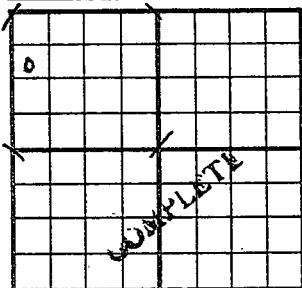

990 Ft. From N Line NW
330 Ft. From W Line Quarter
 1st. Report
 Completion MAR 11 1953
 Remarks Wildcat
Glenn Peel - Contr.
 Spudding Date 12-4-52

Drlg. Data Oil well TD 4720
8" @ 290 Anhy 2170 Top. 3627
Heeb. 3901 Tor. 3928 Lans. 3944
DST 4005-28 open 20 min. Rec. 570' oil
40' mud 1290# B KC 4153 Miss. ch. 4448
Miss. lime 4499 Dol. 4507-79 Arb. 4602
TD 4720 5" @ 4155 DST 4087-97
open 1 hr. Rec. 6' mud, oil specks 0#
DST 4452-80 open 1 hr. Rec. 40' mud &
wtr. 985# DST 4513-41 open $\frac{1}{2}$ hr.
Rec. 2565' sul & sw 1200# DST 4628-35
open $\frac{1}{2}$ hr. Rec. 180' sw 1270#
CO to 4110 12/ 4092-96 S/ 21 gm
500 A S/ 7 bo 7 hr. 1500 A

J. G. McGEHEE

Drig. Data

S/ 145 bo 5 hr. & SW SP 4071 24/ 4023-31

FU 1600' fluid 21/ 3985-93 S/ 430 bo

CO to 4020 $\frac{1}{2}$ 64/ 4002-18 S/ 32 goph

3 hr. 500 A S/ 13.8 boph 5 hr.

P/ 60 bopd ~~Comp. 216 bopd~~

☒	MSC
☒	Disc Map
☒	Finance Map
☒	Tracings
☒	Land Well Map
☒	Land Small Map
☒	Scout Cards

MAR 17 1953