

O.W.W.O.

Sheridan

KANSAS

Sec. 27 Twp. 6 R. 29W

Well No. #3 Wessel Farm

Westpan-Hydrocarbon Company

WOODR HAY
~~Tom Allen~~ Contractor

WESSEL POOL


Ft. from N. Line

990 Ft. from S. Line

Ft. from E. Line

990 Ft. from W. Line

NE SW NW

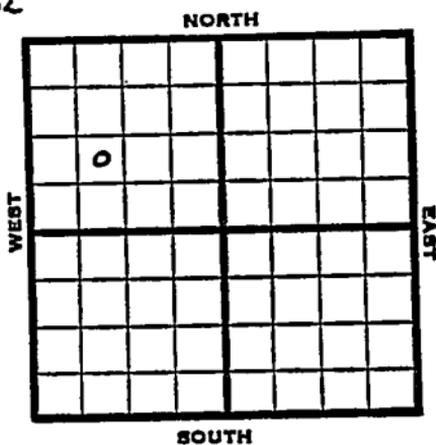

1953

Elev. 2832' REPORT

6/24

C & P

7/1

8" @ 266'
Drlg. 3044'

7/8

Anhy 2550, Top 3721, Heeb 3914, Tor 3942, Lans 3955.

DST 4008-35 1 hr, 5' M

DST 4084-4120 1 hr, 8' M, 55#

RTD 4150

5" @ 4149'

7/22

"

7/29

"

8/5

Spud 6-24-53

D&A

TD 4150'

8" @ 266

Anhy 2550, Top 3721, Heeb 3914, Tor. 3942, Lans 3955,

DST 4008-35, opn 1 hr., rec. 5' mud, 0#

DST 4084-4120, opn 1 hr., rec. 8' mud, 55#

TD 4150

5" @ 4149', CO to 4140

16/4136-37, 16/3080-81, CO to 4130,

32/4105-09, 500A, S/5 bwph, CO to 4127,

23/4106-10, 500A, S/ 3 bo 5 bw 15 hrs.,

st-frac, 2000A, S/2 3/4 bo 7 1/2 bw 12 hrs

SP 4046, 25/4022-26, 500A, S/2 3/4 bw

D&A

ABANDONED OVER

O.W.W.O.

1953

9/2 Heeb 3914, Tor 3942, Lans 3955,
 OTD 4150
 5" @ 4149½
 SP 4046
 25/4022-26, 500A, S/2-3/4 BWPB, SO
 Perf 4022-26, to CO & Reperf

9/9 Sq. 4022-26, CO 4150'

9/16 NR

9/23 NR

10/7 D & A TD 4150' Heeb 3941'
 Tor. 3942' Lans 3955'
 OTD 4150' 5" @ 4149½' SP 4046
~~25/4022-26~~ 25/4022-26 500 A
 S/2-3/4 BWPB Perf 4022-26
 CO to 4150' D & A

ABANDONED

1953

O.W.W.O.

10/21 Heeb 3914', Tor 3942', KC 3955',
 OTD 4150'
 5" @ 4149'
 SP 4046
 25/.4022-26 500 A S/ 2 3/4 bwph
 Sq. perf 4022-26
 CO to 4120

10/28 NR

11/11 NR

11/18 "

12/16 "

1954

1/20 NR

2/10 Oil well TD 4150 Heeb 3914
 Tor. 3942 KC 3955 OTD 4150
 5" @ 4149 SP 4046 25/4022-26
 500 A S/2-3/4 BWPB Sq. perf 4022-
 26 CO to 4120 19/4108-14 500 A
 S/½ BO 2 hr. SP 4102 Hydro.
 SP 4096 A-frac. S/4½ BFPB 36 hr.
 90% wtr. Winterset 4107-18
 S/1-3/4 BOPB 24 hr.
 Comp. 14 BOPD 2% wtr.

COMPLETED

County Sheridan State Kansas

Sec. 27 (Blk. 6 (Sur. 29W (Twp.) (Rge.) Map No.

Operator Westpan-Hydrocarbon

Well No. 3 Farm Wessel

Elev. _____ Location NE SW NW

990 Ft. From S Line NW

990 Ft. From W Line Quarter

1st. Report JUN 24 1953

Completion _____

Remarks _____

Tom Allen - Contr.

Spudding Date _____

Drig. Data _____

Cellar & pits

County Sheridan State Kansas

Sec. 27 (Blk. 6) (Sur. Rge.) 29W Map No. _____

Operator Westpan-Hydrocarbon

Well No. 3 Farm Wessel

Elev. 2832 Location NE SW NW

990 Ft. From S Line NW

990 Ft. From W Line Quarter

1st. Report _____

Completion AUG 5 1953

Remarks _____

Tom Allen - Contr.

Spudding Date 6-24-53

Drlg. Data D & A TD 4150

8" @ 266 Anhy 2550 Top. 3721

Heeb. 3914 Tor. 3942 Lens. 3955

DST 4008-35 open 1 hr. Rec. 5' mud 0#

DST 4084-4120 open 1 hr. Rec. 8' mud

55# TD 4150 5" @ 4149 CO to 4140

16/ 4136-37 16/ 4080-81 CO to 4130

32/ 4105-09 500 A S/ 5 bwph CO to 4127

23/ 4106-10 500 A S/ 3 bo 5 bw 15 hr.

st-frac 2000 A S/ 2 3/4 bo 7 1/2 bw 12 hr

SP 4046 25/ 4022-26 500 A S/ 2 3/4 bw

D & A

J. G. McGEHEE

O.W.W.O.

County Sheridan State Kansas

Sec. 27 (Blk.) 6 (Sur.) 29W Map No.

Operator Westpan-Hydrocarbon

Well No. 3 Farm Wessel

Elev. 2832 Location NE SW NW

990 Ft. From S Line NW

990 Ft. From W Line Quarter

1st. Report SEP 2 1953

Completion O.W.W.O.

Remarks OWWO

Wood & Hay - Contr.

Spudding Date

Drlg. Data Wessel Pool

Heeb. 3914 Top. 3942 Lens. 3955

OTD 4150 5" @ 4149 1/2 SP 4046

25/ 4022-26 500 A S/ 2 3/4 bwph SO

Perf/ 4022-26 to CO & reperf.

O.W.W.O.

County Sheridan State Kansas

Sec. 27 (Blk.) 6 (Sur.) 29W Map No.

Operator Westpan-Hydrocarbon

Well No. 3 Farm Wessel

Elev. 2832 Location NE SW NW

990 Ft. From S Line NW

990 Ft. From W Line Quarter

Ist. Report

Completion **O.W.W.O.**

Remarks Wessel Pool

Wood & Hay - Contr.

Spudding Date

Drlg. Data D & A TD 4150

Heeb. 3941 Tor. 3942 Lans. 3955

OTD 4150 5" @ 4149 $\frac{1}{2}$ SP 4046

25/ 4022-26 500 A S/ 2 3/4 bwph

perf/ 4022-26 CO to 4150

D & A

