


Section 27 Township 6 Range 29W

Well No. #4 Wessel

Company Westpan-Hydrocarbon

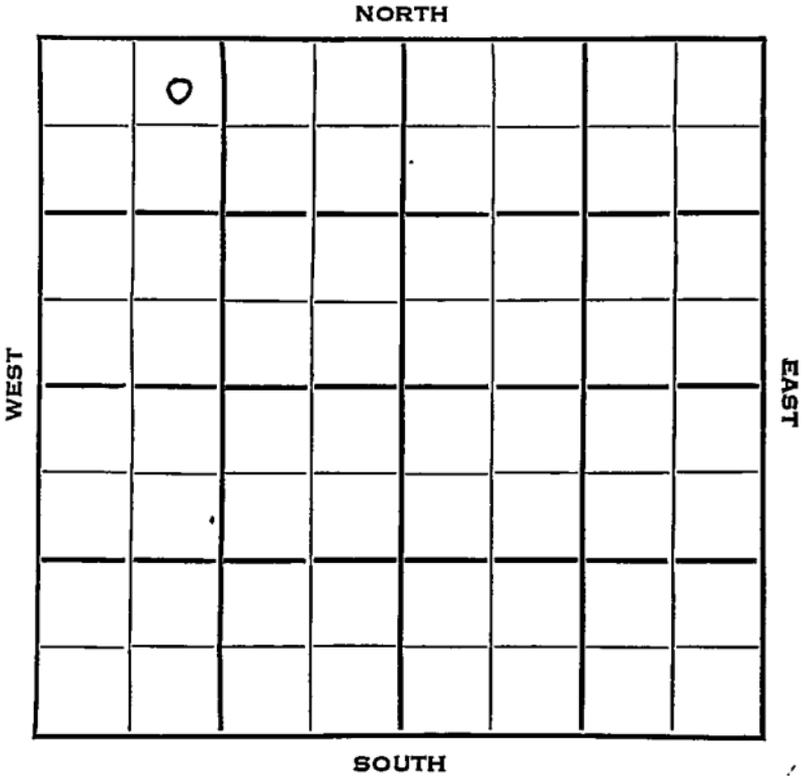

Sec. 27 Twp. 6 R. 29W ✓

Well No. #4 Wessel Farm

Westpan-Hydrocarbon Company

Bill Hay Contractor

Wessel Pool


330 Ft. from N. Line

\_\_\_\_\_ Ft. from S. Line

\_\_\_\_\_ Ft. from E. Line

990 Ft. from W. Line

NE NW NW

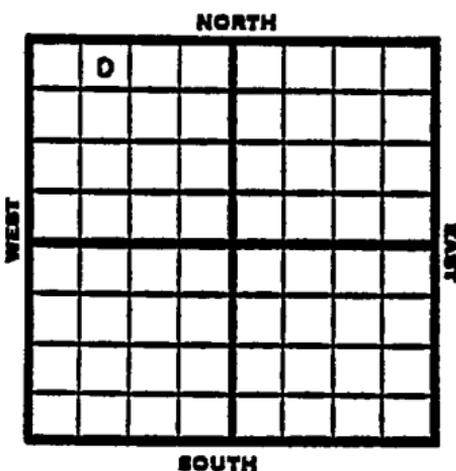

1953

Elev. 2817'

REPORT

9/2 Spud 8-27-53  
8" @ 230  
Drlg. 3075'

9/9 Heeb 3903, Tor 3929, Lans 3941  
DST 3993-4020, 1 hr. 215' wtr.

9/16 DST 4074-4110' failed. RTD 4139'  
Schl 5" @ 4138'

9/23 16/4118-19, 16/4082-83, sq.

10/28 NR

11/4 Spud 8-27-53 Oil well TD 4139  
8" @ 230 Heeb 3903 Tor. 3929  
Lans 3941  
DST 3993-4020 open 1 hr rec 215' wtr.  
DST 4074-4110 failed. TD 4139  
5" @ 4138 16/4118-19 16/4082-83  
20/4095-98 500 A S/3 1/2 BOPH 24 hr.  
1500 A S/6 BOPH 17 hr. P/4 1/2 BOPH  
6omp. 108 BOPD

**COMPLETED**

County Sheridan State Kansas

Sec. 27 (Blk. 6) (Sur. 29W) (Twp.) (Rgs.) Map No.

Operator Westpan-Hydrocarbon

Well No. 4 Farm Wessel

Elev. 2817 Location NE NW NW

0				

330 Ft. From N Line NW

990 Ft. From W Line Quarter

Ist. Report SEP 2 1953

Completion \_\_\_\_\_

Remarks \_\_\_\_\_

Bill Hay - Contr.

Spudding Date 8-27-53

Drlg. Data Wessel Pool

8" @ 230 drlg. 3075

