Rooks


DX 78-1

KANSAS

Section 27 Township 6 Range 19W

Well No. #1 Jones

Company Isern Drlg.

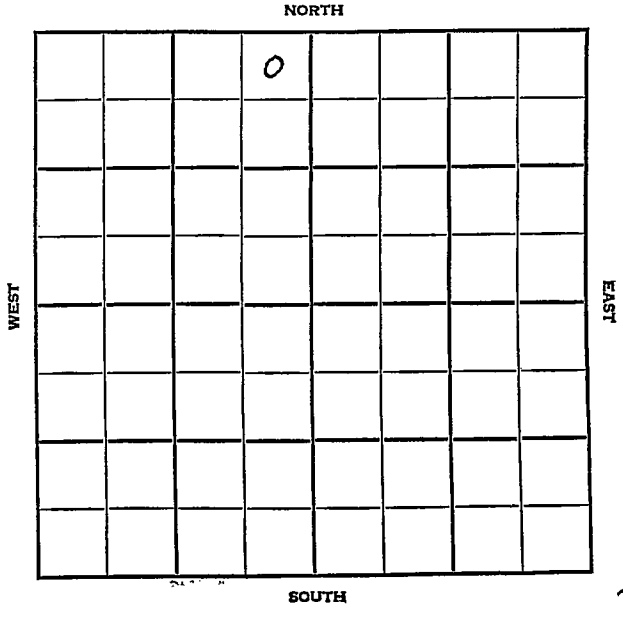

3

Rooks KANSAS

SEC.	TWP.	R.
27	6	19W

WELL NO.

#1 Jones FARM
COMPANY

Isern Drlg.
CONTRACTOR


Isern Drlg.
Wildcat

330 Ft. from N. Line

Ft. from S. Line

330 Ft. from E. Line

Ft. from W. Line

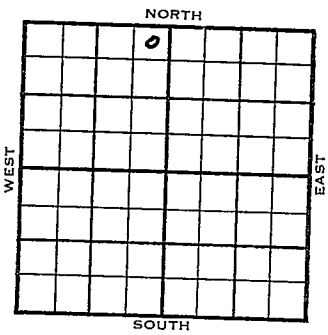

NE NE NW
Gulf - DHM

1954	ELEVATION 2067'	REPORT
5/5	Spud 5-2-54 8" @ 192'	
5/12	Spud 5-2-54 D & A TD 3618 8" @ 192 Anhy 1620 Heeb 3258 Tor. 3280 Lans 3296 DST 3461-91 open 3/4 hr, rec 6' mud O# B KC 3517 Cong. 3574 Gr. wash 3588 Gr. 3614 TD 3618 D & A **ABANDONED**	

DX-78

FORM 275 FOR SALE BY KANSAS BLUE PRINT CO.

County Rooks State Kansas

Sec. 27 (Blk. Twp.) 6 (Sur. Rge.) 19W Map No.

Operator Isern Drlg.

Well No. 1 Farm Jones

Elev. Location NE NE NW



330 Ft. From N Line NW

330 Ft. From E Line Quarter

1st. Report MAY 5 1954

Completion

Remarks Gulf - DFM
Isern Drlg. - Contr.

Spudding Date 5-2-54

Drlg. Data Wildcat

8" @ 192

J. G. McGEHEE

FORM 275 FOR SALE BY KANSAS BLUE PRINT CO.


County Rooks State Kansas

Sec. 27 (Blk. Twp.) 6 (Sur. Rge.) 19W Map No.

Operator Isern Drlg.

Well No. 1 Farm Jones

Elev. 2067 Location NE NE NW

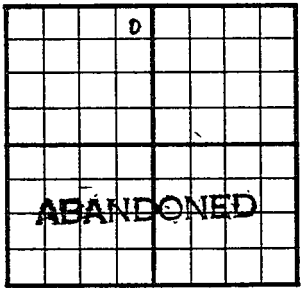

330 Ft. From N Line NW

330 Ft. From E Line Quarter

1st. Report

Completion MAY 1 2 1954

Remarks Wildcat

Isern Drlg. - Contr.

Spudding Date 5-2-54

Drlg. Data D & A TD 3618

8" @ 192 Anhy 1620 Heeb. 3258

Tor. 3280 Lans. 3296 DST 3461-91

open 3/4 hr. Rec. 6' mud 0# B KC 3517

Cong. 3574 Gr. wash 3588 Gr. 3614

TD 3618

D & A

J. G. McGEHEE