

Section 28 Township 6 Range 29W

Well No. #2 Emigh

Company Henderson Oil

NORTH

							0

SOUTH

WEST

EAST

Sheridan

KANSAS

SEC.	TWP.	R.
28	6	29 W

WELL NO.

2 Emigh

FARM

COMPANY

Henderson Oil

CONTRACTOR

Bill Hay


330 Ft. from N. Line

Ft. from S. Line

330 Ft. from E. Line

Ft. from W. Line

NE NE NE

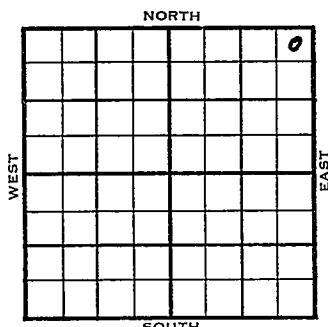

	ELEVATION	REPORT
1953	2819'	
10/7	Spud 10-3-53 8" @ 256 Drlg. 1850'	
10/14	Heeb 3901', Tor 3927', Lans 3939' DST 3986-4024, 1 hr., 70' ocm, 1320# Drlg. 4048'	
10/21	DST 4064-4101, 1 hr., 142' HOCM, 280# RTD 4136 5" @ 4136'	
10/28	CO 4123' 16/4082-83 Sq 16/4114-15 Sq. CO 4123' 19/4094-4100 1 BOPH 1000 A S/10 BOPH S/15 BOPH 3 hrs. S/10 BOPH 14 hrs.	
11/4	Spud 10-3-53 Oil well TD 4136 8" @ 256 Heeb 3901 Tor. 3927 Lans 3939 DST 3986-4024 open 1 hr rec 70' OCM 1320# DST 4064-4101 open 1 hr, rec 142' HOCM 280# TD 4136' 5" @ 4136 CO to 4123 16/4082-83 16/4114-15 CO to 4123 19/4094-4100 1 BOPH 1000 A S/10 BOPH S/15 BOPH S/10 BOPH Comp. 170 BOPD	

County Sheridan State KansasSec. 28 (Blk.) 6 (Sur.) 2 9W Map No.Operator Henderson OilWell No. 2 Farm EmighElev. Location NE NE NE

						0

FIRST REPORT

330 Ft. From N Line NE330 Ft. From E Line Quarter1st. Report OCT 7 1952

Completion

Remarks

Bill Hay - Contr.Spudding Date 10-3-53

Drlg. Data

8" @ 256 drlg. 1850

County Sheridan State KansasSec. 28 (Blk. 6 (Sur. 29W Map No. 29W) (Twp.) (Rge.)Operator Henderson OilWell No. 2 Farm EmighElev. 2819 Location NE NE NE

						0

330 Ft. From N Line NE330 Ft. From E Line Quarter

1st. Report

Completion NOV 4 1953

Remarks

Bill Hay - Contr.Spudding Date 10-3-53Drlg. Data Oil well TD 41368" @ 256 Heeb. 3901 Tor. 3927Lans. 3939 DST 3986-4024 open 1 hr.Rec. 70' ocm 1320# DST 4064-4101open 1 hr. Rec. 142' hocm 280#TD 4136 5" @ 4136 CO to 412316/ 4082-83 16/ 4114-15 CO to 412319/ 4094-4100 1 boph 1000 AS/ 10 boph S/ 15 boph S/ 10 bophComp. 170 bopd

J. G. McGEHEE