

KANSAS


Graham

FORM 51 5M 2-38 TPCO.

Section 29 Township 6 Range 23-W

Well No. 1 Parker

Company Duwe & Farris & Atlantic

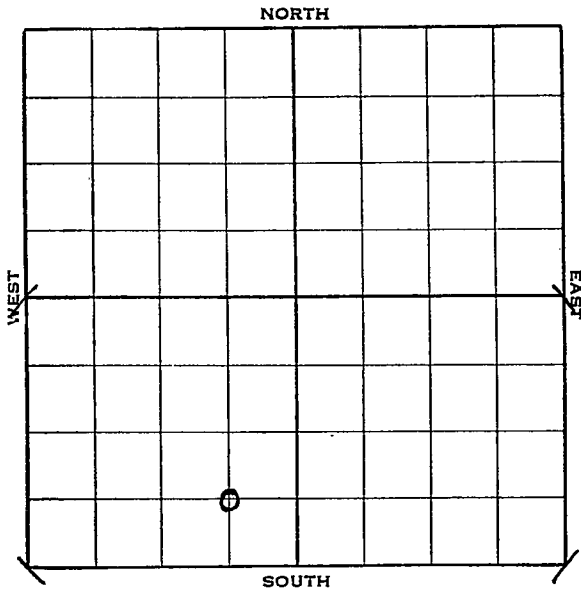

14

29

6

23-W

Sec. _____ Twp. _____ R. _____

Well No. #1 Parker Farm

Duwe & Farris & Atlantic Company


_____ Ft. from N. Line

660 Ft. from S. Line

660 Ft. from E. Line

_____ Ft. from W. Line

Elev. 2472

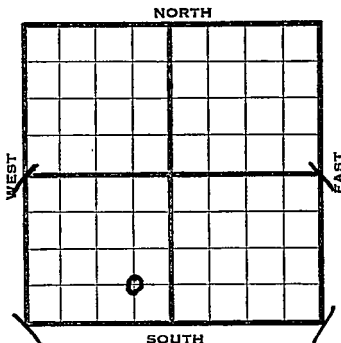

1938	REPORT
8/24	R. R.
9/2	R U R
9/9	10" - 259'. Anhy 2153'. Dlg. 2368'.
9/16	Fort Riley 2720'. Howard 3370'. Dlg. 3385'.
9/23	Lans. 3735'. B.K.C. 3960'. Marmaton 4045'. Dlg. 4097'.
9/28	Cong. 4121'. Simp. 4146'. Arb. 4176'. T. D. 4206'. Porosity - No shows.
	ABANDONED

Handwritten notes:
3752
4176
2153
26

Handwritten notes:
4176
4206
2472
1704

Graham **KANSAS**

Map No. 134 Sec. 29 Twp. 6 R. 23W

Well No. 1 Parker

Duwe & Farris & Atlantic Company

Contractor

FIRST REPORT

C SE SW

 Ft. from N. Line

660 Ft. from S. Line

660 Ft. from E. Line

 Ft. from W. Line

SECTION PLAT

	0		

Location

Rig up

Drilling and Remarks:

RR

RECORD

Cased in., ft.

Sand

Gas

Oil

Total Depth

PRODUCTION

1st 24 hrs. Nat.

1st 24 hrs. after shot ?

Gas Cu. Ft.

Dry Hole

Abandoned

Date

AUG 24 1938 19

H. D. Hatfield

Scout

Graham **KANSAS**

Map No. 134 Sec. 29 Twp. 6 R. 23W

Well No. 1 Parker

Duwe & Farris & Atlantic Company

Contractor

ABANDONED

C SE SW

 Ft. from N. Line

660 Ft. from S. Line

660 Ft. from E. Line

 Ft. from W. Line

SECTION PLAT

	0		

Location

Rig up

Drilling and Remarks:

Cong 4121

Simp 4146

Arb 4176

T.D. 4206

Porosity - No shows

DYA

RECORD

Cased in., ft.

Sand

Gas

Oil

Total Depth 4206

PRODUCTION

1st 24 hrs. Nat.

1st 24 hrs. after shot

Gas Cu. Ft.

Dry Hole

Abandoned

Date

SEP 28 1938 19

H. D. Hatfield Scout