FORM 51


Osborne

KANSAS

Section 29 Township 6 Range 15W

Well No. #1 DeLancy

Company Anderson-Prichard

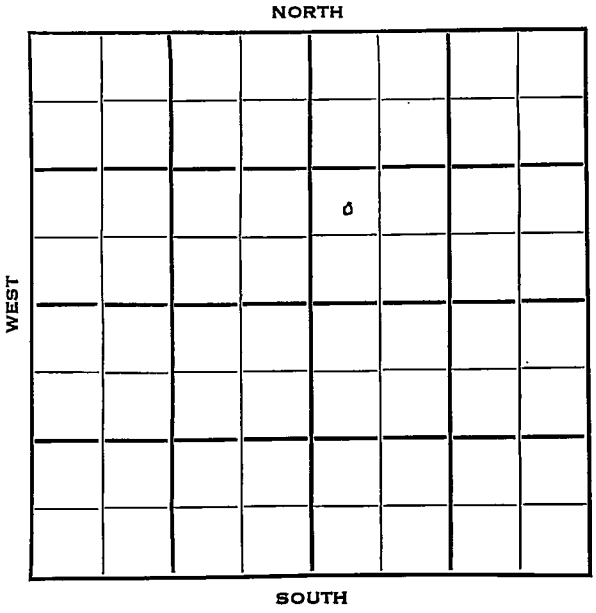


7

FORM 252-B

Osborne KANSAS ✓

Sec. 29 Twp. 6 R. 15 W

Well No. # 1 De Lancy Farm

Anderson-Prichard Company

Glenn Peel Contractor

Wildcat


____ Ft. from N. Line

990 Ft. from S. Line

____ Ft. from E. Line

330 Ft. from W. Line

NW SW NE

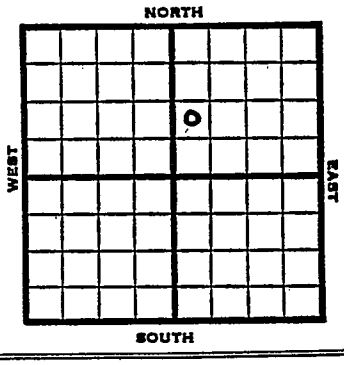


| 1953 | Elev. 1842 REPORT |
|---|---|
| 2/4 | Spud 1-31-53<br>8" @ 198<br>Drlg. 900' |
| 2/12 | Top 2846' Heeb 3084' Tor 3118'<br>Lans. 3143'<br>Drlg. 3597' |
| 2/18 | Spudding date 1/31/53<br>Drlg. D&A TD 4010<br>8" @ 198 Top 2846 Heeb 3084, Tor. 3118, Lans. 3143, Cong. 3589<br>Miss. 3680, Viola 3769 Simp 3920<br>Arb. 3965 TD 4010<br>D & A |

ABANDONED

FORM 275 FOR SALE BY KANSAS BLUE PRINT CO.


County Osborne State Kansas

Sec. 29 (Blk. Twp.) 6 (Sur. Rge.) 15W Map No.

Operator Anderson-Prichard

Well No. 1 Farm De Lancy

Elev. Location NW SW NE

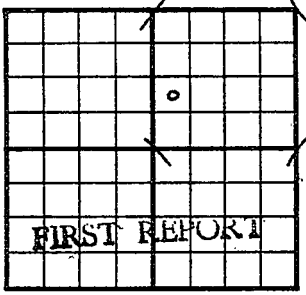


990 Ft. From S Line NE

330 Ft. From W Line Quarter

1st. Report FEB 4 1953

Completion

Remarks Glenn Peel - Contr.

Spudding Date 1-31-53

Drlg. Data Wildcat

8" @ 198 drlg. 900

J. G. McGEHEE

FORM 275 FOR SALE BY KANSAS BLUE PRINT CO.


County Osborne State Kansas

Sec. 29 (Blk. Twp.) 6 (Sur. Rge.) 15W Map No.

Operator Anderson-Prichard

Well No. 1 Farm DeLancy

Elev. 1842 Location NW SW NE

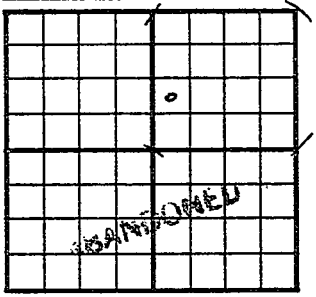


990 Ft. From S Line NE

330 Ft. From W Line Quarter

1st. Report

Completion FEB 1 8 1953

Remarks Wildcat

Glenn Peel - Contr.

Spudding Date 1-31-53

Drlg. Data D & A TD 4010

8" @ 198 Top. 2846 Heeb. 3084

Tor. 3118 Lans. 3143 Cong. 3589

Miss. 3680 Viola 3769 Simp. 3920

Arb. 3965 TD 4010

D & A

J. G. McGEHEE