


Section 3 Township 6 Range 27-W

Well No. #4, Carlton

Company Continental Oil Company

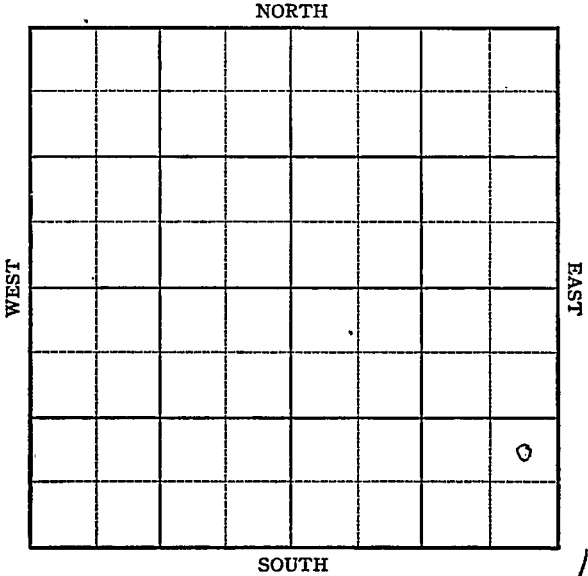

16

Sec. 3 Twp. 6 R. 27W

Well No. #4 Carlton

Continental

Company

Adell

Ft. from N. Line


990

Ft. from S. Line

330

Ft. from E. Line

Ft. from W. Line

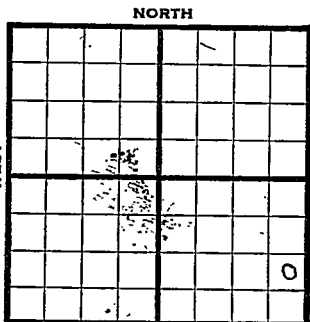

NE SE SE

1946

Elev. 2609

REPORT

7/31 RUR

8/6 10" @ 242 WOC

8/13 Drlg 3030'

8/20 Lans 3687'

Drlg 3790'

8/27 6" @ 3874

TD 3875 RUST

9/5

Lans 3647

6" @ 3874

Perf.

TD 3 874

Water

ABANDONED

KANSAS Kansas Pool Name Adell

Map No. _____ Sec. 3 Twp. 6 R. 27W

Well No. 4 Carlton

Continental Company

ABANDONED Contractor

NE SE SE

E1.2609

SECTION PLAT

_____ Ft. from N. Line

990 Ft. from S. Line

330 Ft. from E. Line

_____ Ft. from W. Line

			d

Sheridan County

Location _____

Rig up _____

Drilling and Remarks: ,

Loss 364.7

6" C 3874

Perf.

Water

RECORD

Cased _____ in., _____ ft.

Sand _____

Gas _____

Oil _____

Total Depth 3874

PRODUCTION

1st 24 hrs. Nat. _____

1st 24 hrs. after shot _____

Gas _____ Cu. Ft.

Dry Hole _____

Abandoned _____

Date

SEP 5 1946 19

S. J. LEWIS

Scout