


Section 3 - Township 6 Range 27W

Well No. 3 Carlton

Company Continental

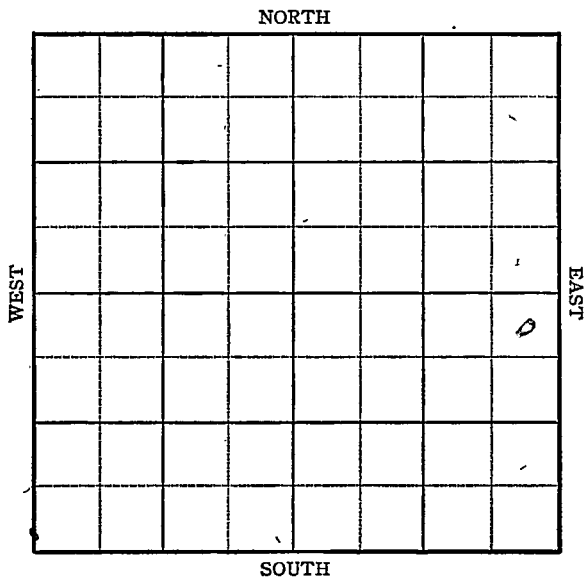

Sec. 3 Twp. 6 R. 27-W

Well No. #3 Carlton Farm
Continental Company


330 Ft. from N. Line

_____ Ft. from S. Line

330 Ft. from E. Line

_____ Ft. from W. Line

NE SE Elev. 2557

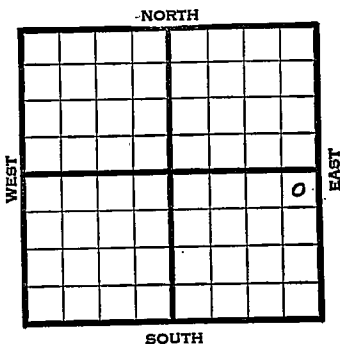

REPORT

1945

8/15	Derrick
8/22	RUR
8/29	10" @ 240 WOC
9/5	Drlg. 2870
9/12	Drlg. 3676
9/19	Lans 3548
	TD 3830'
	6" @ 3829' RUST
9/26	12 shots 3646-3654 500 acid.
	Swab 20 oil plus 1 WPH 9 hrs.
10/3	Swab 25 oil per hr. 12 hrs.
10/10	" " " " "
10/17	" " " " "
10/24	" " " " "
10/31	" " " " "
11/7	" " " " "
11/14	" " " " "
11/21	Lans 3548
	6" @ 3829
	Perf. 500 acid.
	TD 3830'
	Pump 600 oil plus 60 Wtr. Pot.
	Grav. 37.0

COMPLETED

Pool Name Ade

KANSAS Kansas

Map No. 135 Sec. 3 Twp. 6 R. 27W

Well No. 3 Carlton

Continental Company

FIRST REPORT

Contractor

NE SE

SECTION PLAT

330 Ft. from N. Line

Ft. from S. Line

330 Ft. from E. Line

Ft. from W. Line

			o

Sheridan County

Location _____

Rig up _____

Drilling and Remarks:
derrick

RECORD

Cased _____ in, _____ ft.

Sand _____

Gas _____

Oil _____

Total Depth _____

PRODUCTION

1st 24 hrs. Nat. _____

1st 24 hrs. after shot _____

Gas _____ Cu. Ft.

Dry Hole _____

Abandoned _____

Date

AUG 15 1945

19

S. J. LEWIS

Scout

KANSAS

Kansas

Pool Name Adel

Map No. 135 Sec. 3 Twp. 6 R. 27W

Well No. 3 Carlton

Continental Company

COMPLETED

Contractor

NE SE

E 12557
SECTION PLAT

			0

330 Ft. from N. Line

_____ Ft. from S. Line

330 Ft. from E. Line

_____ Ft. from W. Line

Sheridan County

Location _____

Rig up _____

Drilling and Remarks:

Lane 3575
6" @ 3529
Prof.
500 acid
Pump 600 oil + 60H
Prof.
370 gal

RECORD

Cased _____ in., _____ ft.

Sand _____

Gas _____

Oil _____

Total Depth 3520

PRODUCTION

1st 24 hrs. Nat. _____

1st 24 hrs. after shot _____

Gas _____ Cu. Ft.

Dry Hole _____

Abandoned _____

Date _____

NOV 21 1945 19

S. LEWIS Scout