


Section 3 Township 6 Range 27W

Well No. 1 A. Carlton

Company Continental

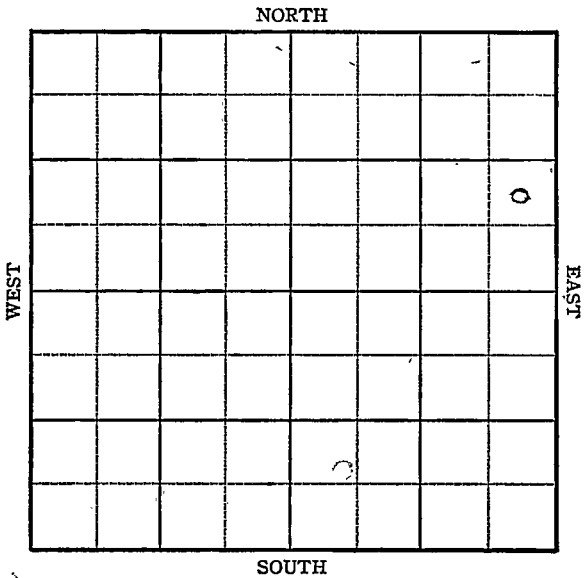

8

Sec. 3 Twp. 6 R. 27-W

Well No. #1 A. Carlton Farm


Continental Company

_____ Ft. from N. Line

990 Ft. from S. Line

330 Ft. from E. Line

_____ Ft. from W. Line

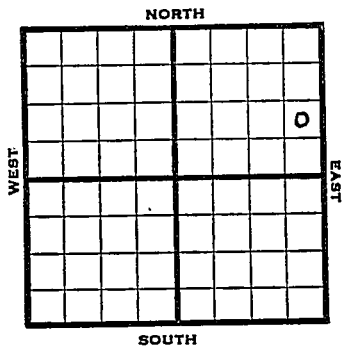

NE SE NE Elev. 2523

REPORT

1945

9/19 Derrick

9/26 RUR

10/3 10" @ 240

Drlg. 2168'

10/10 Drlg. 3355

10/17 Lans. 3570

TD 3830'

ABANDONED

