


Section 3 Township 6 Range 27W

Well No. #1 Kinser

Company Sauvage & Dunne

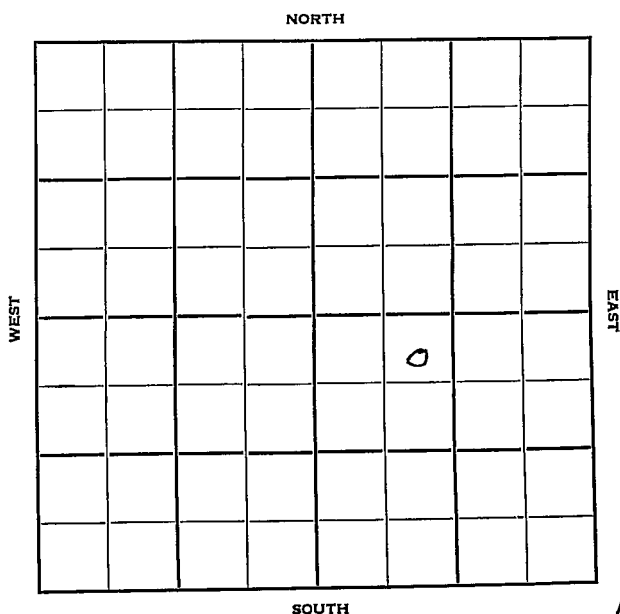

Sheridan

KANSAS

Sec. 3 Twp. 6 R. 27W

Well No. #1 Kinser Farm

Sauvage & Dunne Company

Contractor


330 Ft. from N. Line

Ft. from S. Line

Ft. from E. Line

990 Ft. from W. Line

NE NW SE

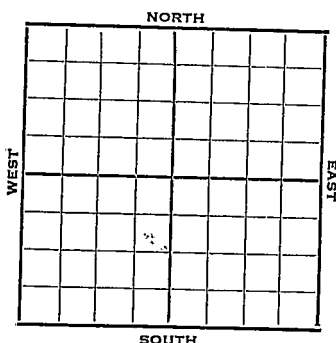

1952 Elev. 2532' R R R E P O R T

9/17 D&A TD 3818
Heeb. 3620 Tor. 3643 KC 3661
RTD 3818' D&A

FIRST REPORT
+
ABANDONED

County Sheridan State Kansas
 Sec. 3 (Blk.) 6 (Sur.) 27W Map No.
 (Twp.) (Rge.)
 Operator Sauvage & Dunne
 Well No. 1 Farm Kinser
 Elev. 2532 RB Location NE NW SE

FIRST REPORT

RECORDED

330 Ft. From N Line SE
990 Ft. From W Line Quarter
 Ist. Report SEP 17 1952
 Completion SEP 17 1952
 Remarks

Spudding Date
 Drlg. Data D & A TD 3818
Heeb. 3620 Tor. 3643 KC 3661
RTD 3818

D & A

J. G. McGEHEE