

Graham


KANSAS

SECTION 30 TOWNSHIP 6 RANGE 25 W

WELL NO. #1 Tedro

COMPANY Jones, Shelburne & Farmer

NORTH

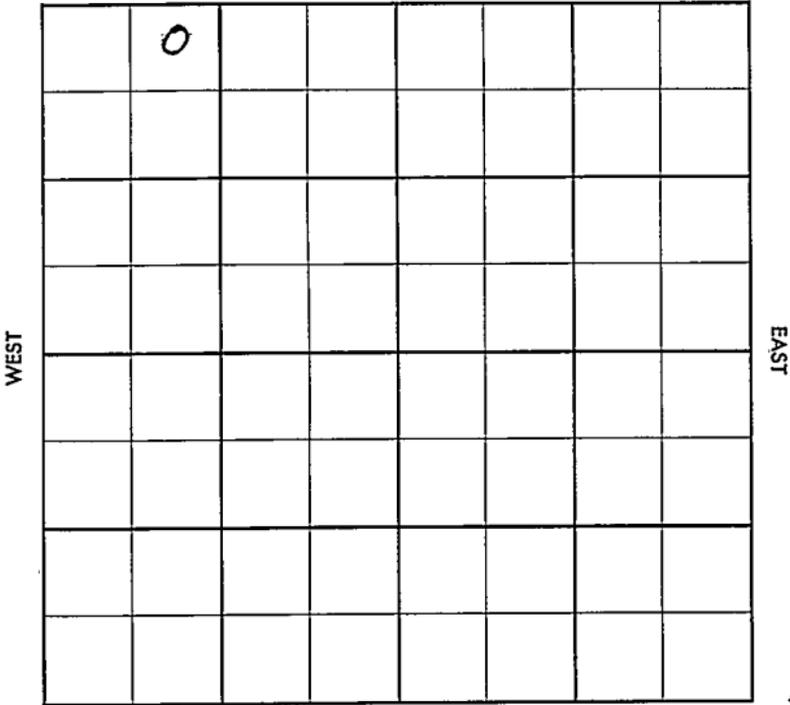

SOUTH

4

Graham

KANSAS

SEC.	TWP.	R.
30	6	25W

WELL NO.

#1 Tedro

FARM

COMPANY

Jones, Shelburne & Farmer

CONTRACTOR

Co. Tools

Wildcat


_____ Ft. from N. Line

_____ Ft. from S. Line

_____ Ft. from E. Line

_____ Ft. from W. Line

NE NW NW

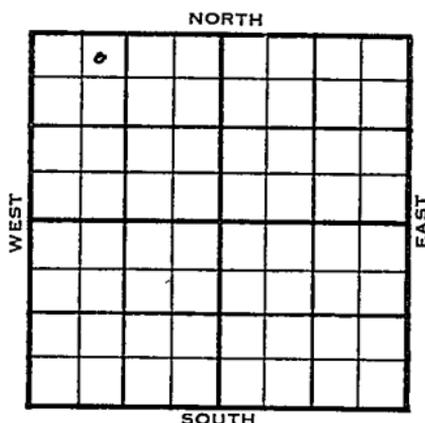

1955

~~2608~~

ELEVATION

2608'

REPORT

10/19

Comm 10-9-55

8" @ 300/150

An~~y~~

2178

H

3641

Tr

3664

L

3680

DST 3695-3722 open 1 hr Rec 100'

hocm 60' muddy wtr 1120/20"

DST 3746-54 open 1 hr Rec 300' gas

70' oil 15' mco 630/20" Drlg 3754

11-23

DST 3757-70 op 1 hr. rec. 15' vhocm

135' oil 550' GIP, 710/20"

DST 3825-35 op 1 hr. rec 530' gas, 70'

oil 1170/20"

DST 3842-50 op 1 hr. rec 800' gas,

300' oil, 1080/20"

5 1/2" @ 3879

CO to 3854, 20/ 3847-52

S/ 6 boph 6 hr., 1000 A

S/ 15 boph 6 hr.

Comp. 124 bopd

B.K.C. 3870

TD 3880'

COMPLETED

County Graham Elev. 2608
 Sec. 30 Twp. 6 Rge. 25W
 Company Jones, Shelburne & Farmer
 FarmName Tedro No. 1

TOPS	DEPTH	LOG	DATUM
Anh.	<u>2178</u>		
Tp.	<u>3611</u>		
H.	<u>3664</u>		
Tr.			
Dg.			
Bl.	<u>3680</u>		
L.			
K.C.			
B.K.C.			
Ce.			
C.			
M.			
M.			
K.			
Mz.			
Me.			
V.			
S.			
S.			
A.			
R.			
PE.			
G.			
T.D.			

Loc. in Sec. NE NW NW
 Geol. _____
 Contr. Co. tools
 Pool. Wildcat

OCT 19 1955

FIRST REPORT

Date Comm. 10-9-55
8" @ 300/150 DST 3695-3722 open 1 hr.
Rec. 100' hoem 60' middy wtr. 1120/20"
DST 3746-54 open 1 hr. Rec. 300' gas
70' oil 15' mco 630/20" drlg. 3754

County Graham Elev. 2608
 Sec. 30 Twp. 6 Rge. 25W
 Company Jones, Shelburne & Farmer
 Farm Name Tedro No. 1

TOPS	DEPTH	LOG	DATUM	Loc. in Sec.
Anh.	2178			NE NW NW
Tp.				
H.	3641		1033	
Tr.	3664		1056	
Dg.				
Bl.				
L.	3680		1072	Geol.
K.C.				
B.K.C.	3870		1262	Contr.
Ce.				Co. tools
C.				
M.				Pool
M.				Wildcat
K.				
Mz.				
Ma.				
V.				
S.				
S.				
A.				
R.				
PE.				
G.				
TD.	3880			

COMPLETE

Date Comm. 10-9-55 NOV 23 1955
 8" @ 300/150 DST 3695-3722 open 1 hr.
 rec. 100' hocm 60' muddy wtr. 1120/20"
 DST 3746-54 open 1 hr. rec. 300' gas
 70' oil 15' mco 630/20" DST 3757-70
 open 1 hr. rec. 15' vhocm 135' oil
 550' GIP 710/20" DST 3825-35 open
 1 hr. rec. 530' gas 70' oil 1170/20"
 DST 3842-50 open 1 hr. rec. 800' gas

300' oil 1080/20" 5 $\frac{1}{2}$ " @ 3879 CO to
385 $\frac{1}{4}$ 20/ 3847-52 S/.6 boph. 6 hr.
1000-A S/.15 boph 6 hr. Comp. 12 $\frac{1}{4}$ bopd

Misc.
Pierce Map
France Map
Tracings
Land Wall Map
Land Small Map
Scout Cards *M*

DEC 1 1955