


Map No. Kans Sec. 30 Twp. 6 R. 17^W

Well No. #1 Law Farm

Marland O. & R. Company

NORTH

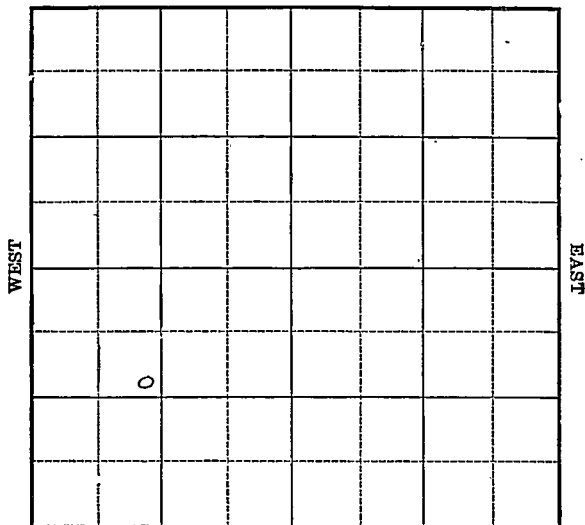

SOUTH

15-2

Location _____

Drilling Remarks

RECORD

Cased _____ in. _____ ft.

Sand _____

Gas _____

Oil _____

Total Depth _____

Rig Up _____

Drilling Remarks

PRODUCTION

1st 24 hrs. Nat. _____

1st. 24 hrs. after shot _____

Gas _____ cu. ft.

Dry Hole _____

Abandoned _____

ROOKS Co.

Map No. **KANSAS** Sec. **30** Twp. **6** R. **17W**Well No. **#1 LAW****Marland O. & P.** Company

Contractor

FIRST REPORT

SECTION PLAT

990 Ft. from N. Line

Ft. from S. Line

Ft. from E. Line

990 Ft. from W. Line

Location -----

Rig up -----

Drilling and Remarks:

Rign. up,

RECORD

Cased ----- in., ----- ft.

Sand -----

Gas -----

Oil -----

Total Depth -----

PRODUCTION

1st 24 hrs. Nat. -----

1st 24 hrs. after shot -----

Gas ----- Cu. Ft.

Dry Hole -----

Abandoned -----

Date

NOV 23 1924

192

M. A. BENEAR

Scout

MAP NO. _____ SEC. 30 TWP. 10 S R. 17 W

WELL NO. Kew

Monland COMPANY

no wall wire CONTRACTOR

SECTION PLAT

0.			

_____ FT. FROM N. LINE

_____ FT. FROM S. LINE

_____ FT. FROM E. LINE

_____ FT. FROM W. LINE

LOCATION _____

RIG UP _____

DRILLING AND REMARKS:
3220 - H₂O

RECORD

CASED _____ IN. _____ FT.

SAND _____

GAS _____

OIL _____

TOTAL DEPTH 3500

PRODUCTION

1ST 24 HRS. NAT. _____

1ST 24 HRS. AFTER SHOT _____

GAS _____ CU. FT.

DRY HOLE /

ABANDONED /

DATE

6/25 192 5

SCOUT

No Maps

Map No. *KANSAS* Sec. *30* Twp. *6* R. *17W*

Well No. *1 Law*

Marland O. & R Company

Contractor

SECTION PLAT

990 Ft. from N. Line

_____ Ft. from S. Line

_____ Ft. from E. Line

990 Ft. from W. Line

ABANDONED

Location _____

Rig up _____

Drilling and Remarks:

J. D 3504

O & A

RECORD

Cased _____ in., _____ ft.

Sand _____

Gas _____

Oil _____

Total Depth _____

PRODUCTION

1st 24 hrs. Nat. _____

1st 24 hrs. after shot _____

Gas _____ Cu. Ft.

Dry Hole _____

Abandoned _____

Date

OCT 6 1925
192

S. J. LEWIS

Scout