


Section 31 Township 6 Range 19W

Well No. #1 A. L. Arrington

Company Magnolia

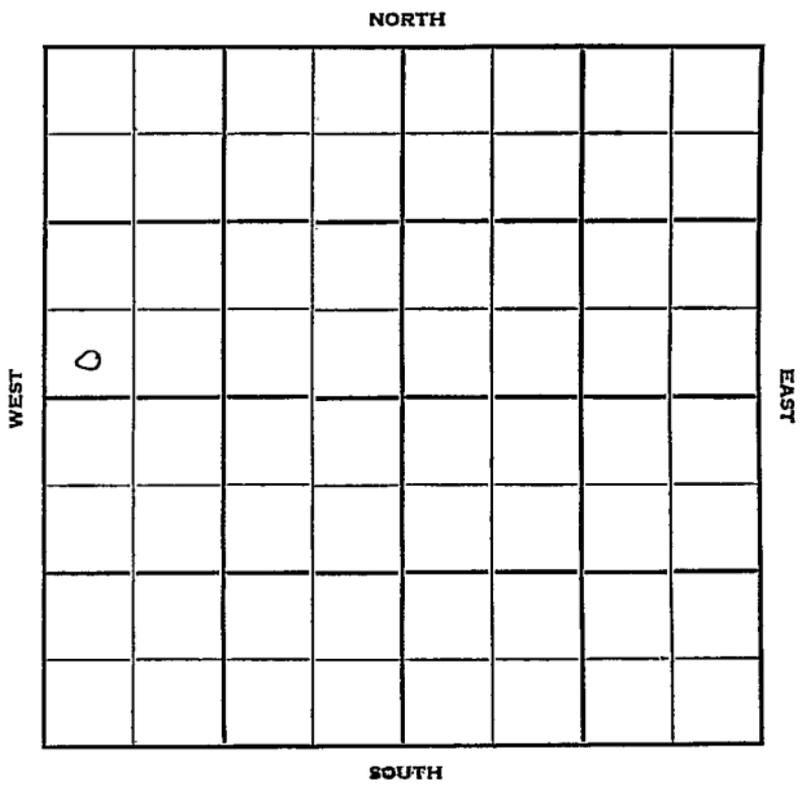

5

Sec. 31 Twp. 6 R. 19W

Well No. #1 A. L. Arrington Farm

Magnolia Company

Contractor

**Slate Pool**


Ft. from N. Line

330' Ft. from S. Line

Ft. from E. Line

330' Ft. from W. Line

SW SW NW

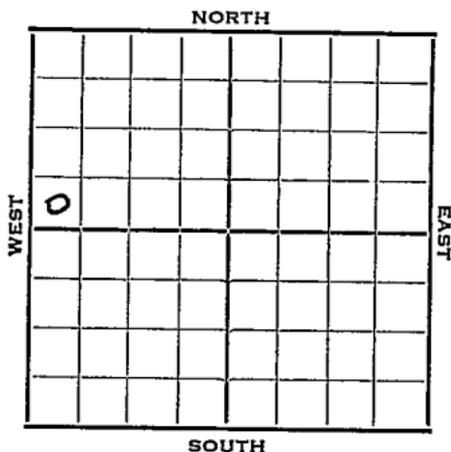

1952 Elev. 2050' REPORT

2/20 Location

3/5 KC 3277'  
Drlg. 3385'

3/12 DST 3357-3445', 1 hr, 91'SOCM  
860# Arb. 3531' RTD 3534'  
6" @ 3532' DP

3/19 CO to 3534 Test VSSO  
DD 3537 Test 12 gal oil ph for  
10 hrs. 1000 A  
S/load 12/3525-29 test 18 gal oil p h  
for 12 hrs. 2000 A B/18 gal oil ph  
DD to 3539 TD B/1 1/4 Boph for 16 hrs  
2000 A S/1 1/4 Boph for 20 hrs.  
POP

4/2 Spud 2-23-52 OilWell TD 3539  
13" @ 195 KC 3277 Heeb. 3238  
KC 3277

DST 3357-3445 opn 1 hr. Rec. 91'  
socm Arb. 3531 TD 3534  
6" @ 3532 DD 3537 Test 12 goph  
10 hr. 1000 A S/load 12/3525-29  
18 goph 12 hr. 2000 A  
B/18 goph DD 3539 B/1 1/4 boph 6 hrs.  
2000 A S/1 1/4 boph 20hr. P/15 bopd  
Comp. 27 bopd

**COMPI ETED**



County \_\_\_\_\_ Rooks \_\_\_\_\_ State Kansas  
 Sec. 31 (Blk. Twp.) 6 (Sur. Rge.) 19W Map No. \_\_\_\_\_  
 Operator Magnolia  
 Well No. 1 Farm A. L. Arrington  
 Elev. 2050 Location SW SW NW


330 Ft. From S Line NW  
330 Ft. From W Line Quarter  
 Ist. Report \_\_\_\_\_  
 Completion APR 2 1952  
 Remarks Slate Pool  
 Spudding Date 2-23-52

Drlg. Data Oil well TD 3539  
13" @ 195 KC 3277 Heeb. 3238  
KC 3277 DST 3357-3445 open 1 hr.  
Rec. 91' socm Arb. 3531 TD 3534  
6" @ 3532 DD 3537 test 12 goph 10 hr.  
1000 A S/ load 12/ 3525-29 18 goph  
12 hr. 2000 A B/ 18 goph DD 3539  
B/ 1 1/2 boph 6 hr. 2000 A S/ 1 1/2 boph  
20 hr. P/ 15 boph Comp. 27 boph

J. G. McGEHEE