


Section 33 Township 6 Range 21W

Well No. #1 Jenkins

Company B & R Drlg. & Wilcox

Wildcat

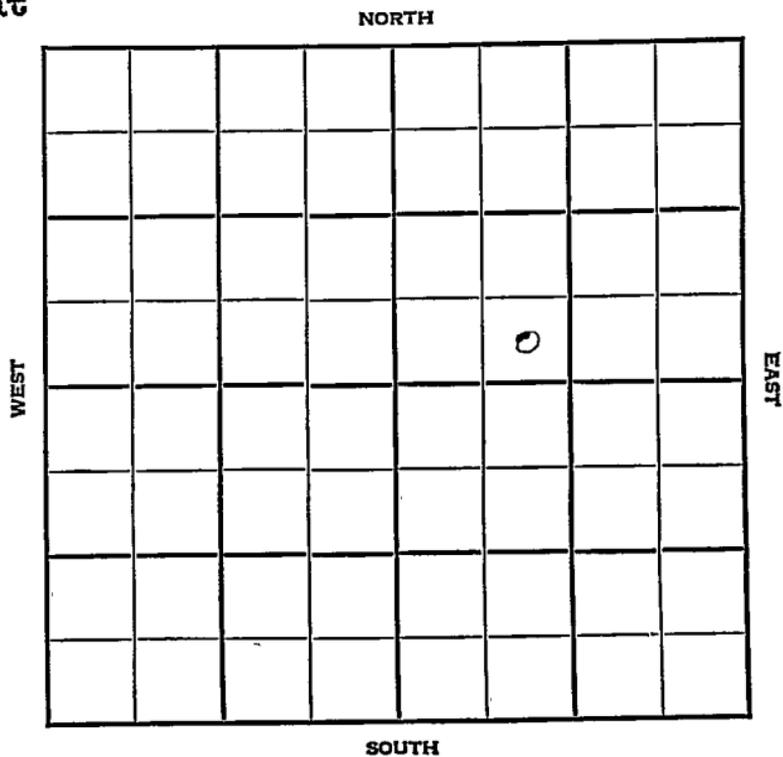

7

KANSAS

Graham

Sec. 33 Twp. 6 R. 21W

Well No. #1 Jenkins Farm

B & R Drlg. & Wilcox Company

Wildcat


Ft. from N. Line

330' Ft. from S. Line

Ft. from E. Line

990' Ft. from W. Line

SE SW NE

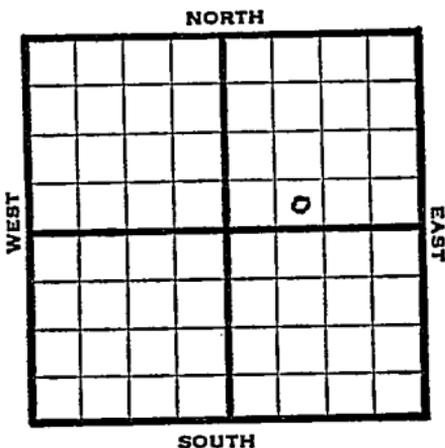

1948

Elev. 2212' REPORT

2/18 Location

2/25 8" @ 188'  
Drlg. 1660'

3/3 Drlg. 3305'

3/10 Lans. 3453'  
Arb. 3724'  
TD 3770'

**ABANDONED**

Wildcat

Form 26 200 Bks. 10-46 Petrol  
Kansas

Map No. \_\_\_\_\_ Sec. 33 Twp. 6 R. 21W

Well No. 1 Jenkins


B & R Drlg. & Wilcox Company

**FIRST REPORT** Contractor

SE SW NE

**SECTION PLAT**

\_\_\_\_\_ Ft. from N. Line  
330. Ft. from S. Line  
\_\_\_\_\_ Ft. from E. Line  
990 Ft. from W. Line

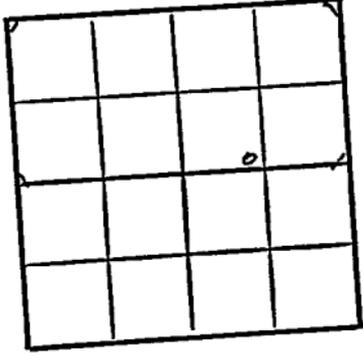

Graham County

Location X

Rig up \_\_\_\_\_

Drilling and Remarks:

**RECORD**

Cased \_\_\_\_\_ in., \_\_\_\_\_ ft.  
Sand \_\_\_\_\_  
Gas \_\_\_\_\_  
Oil \_\_\_\_\_  
Total Depth \_\_\_\_\_

**PRODUCTION**

1st 24 hrs. Nat. \_\_\_\_\_  
1st 24 hrs. after shot \_\_\_\_\_  
Gas \_\_\_\_\_ Cu. Ft.  
Dry Hole \_\_\_\_\_  
Abandoned \_\_\_\_\_

Date

FEB 18 1948 19

S. J. LEWIS

Scout

Map No. 133 Sec. 33 Twp. 6 R. 21W

Well No. 1 Jenkins

B & R Drlg. & Wilcox Company

ABANDONED Contractor

SE SW NE

*E1,2212*  
SECTION PLAT


         Ft. from N. Line

330 Ft. from S. Line

         Ft. from E. Line

990 Ft. from W. Line

Graham County

Location                                 

Rig up                                 

Drilling and Remarks:

*Loss 3453  
Cu 13724*

RECORD

Cased          in.,          ft.

Sand                                 

Gas                                 

Oil                                 

Total Depth 2720

PRODUCTION

1st 24 hrs. Nat. 51A

1st 24 hrs. after shot         

Gas          Cu. Ft.

Dry Hole                                 

Abandoned                                 

Date

MAR 10 1948 19 S. J. LEWIS Scout