

KANSAS

Section 34 Township 6 Range 23^W

Well No. #1 Dietz

Company Anderson & Prichard

NORTH

0							

WEST

EAST

SOUTH

13

KANSAS

Graham



Sec. 34 Twp. 6 R. 23W

Well No. #1 Dietz Farm

Anderson & Prichard Company

Wildcat


_____ Ft. from N. Line

330' Ft. from S. Line

_____ Ft. from E. Line

330' Ft. from W. Line

SW/c

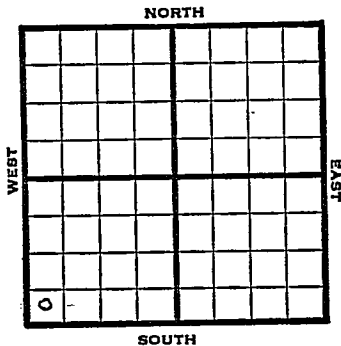

1948

Eli 2441'

REPORT

7/14

8" @ 316'

WOC

7/21

Lensing 3710'

Drlg 3830'

7/28

BKC 3906'

Cong 4060'

Arb. 4102'

TD 4143'

Aband.

ABANDONED

Map No. _____ Sec. 34 Twp. 6 R. 23W


Well No. 1 Dietz

Anderson & Prichard Company

FIRST REPORT Contractor

SW/C

SECTION PLAT

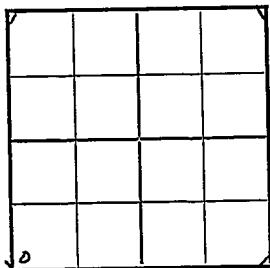

_____ Ft. from N. Line

330 Ft. from S. Line

_____ Ft. from E. Line

330 Ft. from W. Line

Graham County

Location _____

Rig up _____

Drilling and Remarks:

R. a.

8" @ 316 WOC

RECORD

Cased _____ in., _____ ft.

Sand _____

Gas _____

Oil _____

Total Depth _____

PRODUCTION

1st 24 hrs. Nat. _____

1st 24 hrs. after shot _____

Gas _____ Cu. Ft.

Dry Hole _____

Abandoned _____

Date

JUL 14 1948 19

S. J. LEWIS Scout

