


Section 34 Township 6 Range 9W

Well No. #1 R. A. Rainhardt

Company A. D. Allison et al

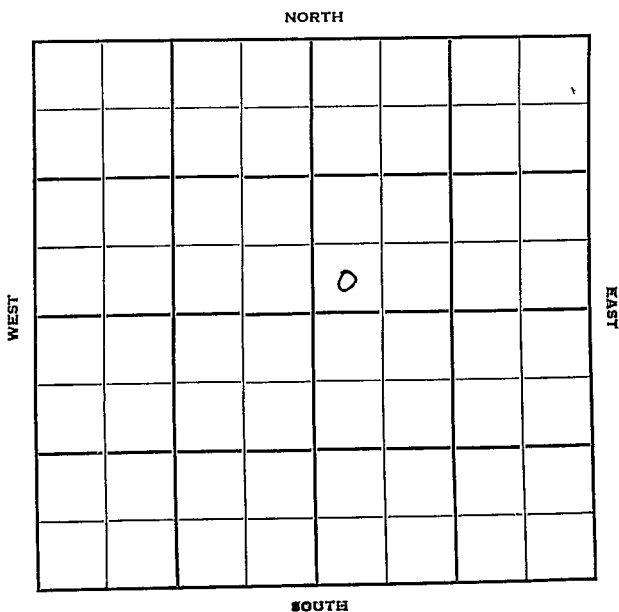

Sec. 34 Twp. 6 R. 9W

Well No. #1 R. A. Rainhardt Farm

A. D. Allison Company

Allison Contractor

Wildcat


Ft. from N. Line

330' Ft. from S. Line

Ft. from E. Line

330' Ft. from W. Line

SW SW NE

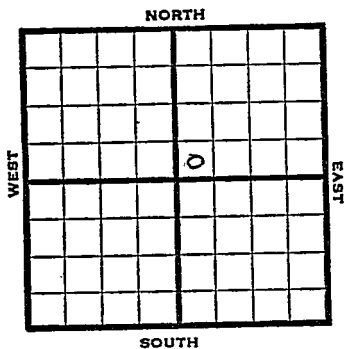

1950 Elev 1427 REPORT

9/13 Spud 9-10-50
Drlg. 205'

10/4 8 5/8" @ 625
Lans 2525 Miss 3192
Arb 3905
TD 3955
D&A

ABANDONED

County **Mitchell** State **Kansas**

Sec. **34** (Blk. Twp.) **6** (Sur. Rge.) **9W** Map No.

Operator **A. D. Allison et al.**

Well No. **1** Farm **R. A. Rainhardt**

Elev. Location **SW SW NE**

FIRST REPORT
O

330 Ft. From S Line NE

330 Ft. From W Line Quarter

Ist. Report **SEP 13 1950**

Completion

Remarks **Core Drill**

Stanolind farmout &

Spudding Date **9-10-50** acreage

Drlg. Data **Wildcat**

drlg. 205

