

KANSAS

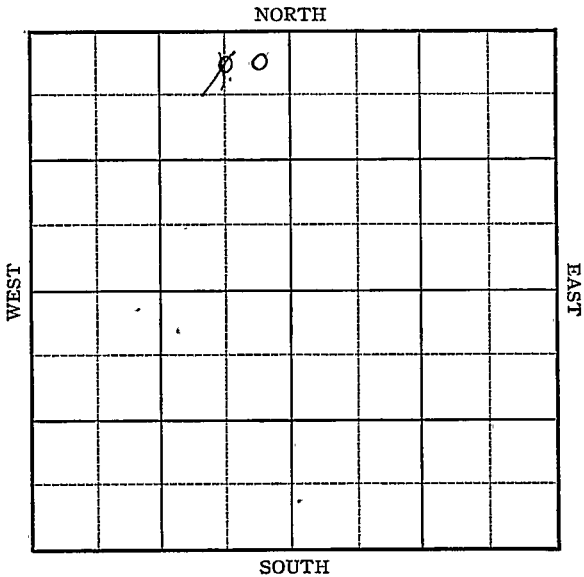
Graham

FORM 51 5M 1-42 PETROL

Section 34 Township 6 Range 21-W

Well No. #1 Pennington

Company Nadel & Gussman et al.



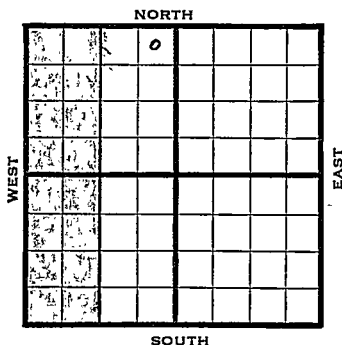
3

KANSAS

Graham

Sec. 34 Twp. 6 R. 21-WWell No. #1 Pemington Farm 2Nadel & Gussman etal. Company

Wildcat

330 Ft. from N. Line Ft. from S. Line330 Ft. from E. Line Ft. from W. Line

1943

Elev. 2263

REPORT

3/31

Location.

4/7

"

4/14

"

4/21

"

4/28

8" @ 540' WOC

5/5

No 8", 10" @ 635'

Anhy. 1902

Drlg. 2970'

5/12

Topeka 3290

Lans 3579

BKC 3726

Congl 3799

Arb. 3812

T.D. 3863'

No shows.

ABANDONED

Graham

KANSAS
 Map No. 3 Sec. 34 Twp. 6 R. 21W

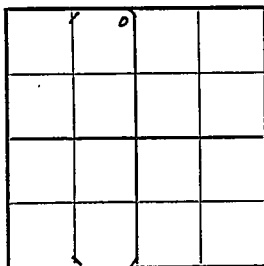
Well No. 1 Pennington

Nadel & Gussman et al. Company

FIRST REPORT Contractor

NE NW

SECTION PLAT

330 Ft. from N. Line Ft. from S. Line330 Ft. from E. Line Ft. from W. Line**WILDCAT**Location XXRig up

Drilling and Remarks:

RECORDCased in., ft.Sand Gas Oil Total Depth **PRODUCTION**1st 24 hrs. Nat. 1st 24 hrs. after shot Gas Cu. Ft.Dry Hole Abandoned

Date

MAR 3 1 1943 19S. J. LEWIS Scout

KANSAS

Map No. 133 Sec. 34 Twp. 6 R. 21WWell No. 1 PenningtonNadel & Gussman et al. Company

ABANDONED

Contractor

NE NW

330 Ft. from N. Line

Ft. from S. Line

330 Ft. from E. Line

Ft. from W. Line

SECTION PLAT

		2	

WILDCAT

Location

Rig up

Drilling and Remarks:

*Top ka 3290**Lans 3578**BTC 3726**Congl 3799**cl 3812**Nocturnal*

RECORD

Cased _____ in., _____ ft.

Sand _____

Gas _____

Oil _____

Total Depth 3868

PRODUCTION

1st 24 hrs. Nat. _____

1st 24 hrs. after shot _____

Gas _____ Cu. Ft.

Dry Hole _____

Abandoned _____

Date

MAY 12 1943

19

S. J. LEWIS Scout