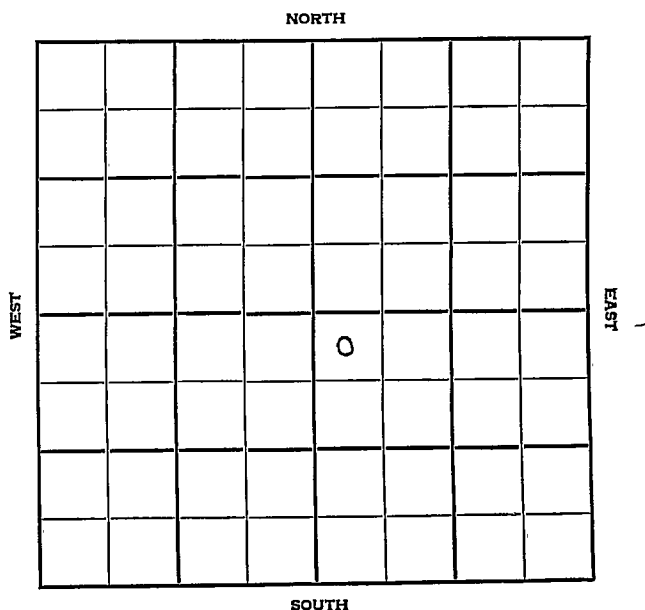


Section 35 Township 6 Range 27 WWell No. #1 ReedCompany Barnett Oil

10

Sheridan

KANSAS

SEC. 35	TWP. 6	R. 27W
------------	-----------	-----------

WELL NO.

#1 Reed

FARM

COMPANY

Barnett Oil

CONTRACTOR

Co. tools


WILDCAT

Ft. from N. Line

Ft. from S. Line

Ft. from E. Line

Ft. from W. Line

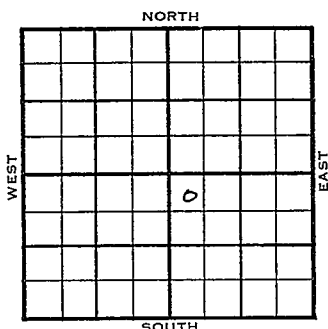

NW NW SE

NCRA & Champlin- DHM

	ELEVATION	REPORT
1955	2709'	
9-14	Comm. 9-12-55	
	8" @ 373/150	WOC
11-23	DST 3878-99 op $\frac{1}{2}$ hr. rec. 5' mud, 150/20"	
	DST 3892-3941 op $1\frac{1}{2}$ hr. rec. 80' free oil, 30' hocr 1090/20"	
	DST 4039-72 op 50 min. rec 15' mud, 580/20"	
	5 $\frac{1}{2}$ " @ 4110/125, 12/ 4060-64, 12, 4059-63, 500 A	
	S/ 3 bfph 10% oil, 12/ 3902-06	
	S/ 173 bf (15 bo) 9 hr., reperf. 3902-06	
	S/ 10 gmoph, 500 A,	
	S/ 2 $\frac{1}{4}$ boph	
	S/ 1.68 boph 4 hr.	
	P/ 88 bo 8/10 of 1% w	
	P/ 27 bo 24 hr., 1500 A	
	S/ 8 bo 124 bwph	
	P/ 5 bf, 90% wtr.	
	D & A	
	Tops: Anh 2410', H. 3861-3860,	
	Tr. 3884-3883, L. 3902-3898, BKC 4119-4114, Marm 4140, M. 4415, Gilmore City 4497, V. 4520-4518, A 4611-4616	
	T.D. 4622'	

County

Sheridan

Elev.

Sec.

35

6

Rge.

27W

Company

Barnett Oil

Farm Name

Reed

No.

1

TOPS

DEPTH

LOG

DATUM

Loc. in Sec.

NW NW SE

Anb.

T.P.

H.

Tr.

Dg.

Bl.

L.

K.C.

B.K.C.

Ce.

C.

M.

M.

K.

Mz.

Ma.

V.

S.

S.

A.

R.

P.E.

G.

T.D.

Geol.

Contr.

Co. tools

Pool

Wildcat

FIRST REPORT

SEP 14 '55

Date Comm.

9-12-55

NGRA & Champlin - DHM

8th

@ 373/150

WOG

Co.

Lse.

No.

Sec.

T.

R.

County Sheridan Elev. 2709
 Sec. 35 Twp. 6 Rge. 27W
 Company Barnett Oil
 Farm Name Reed No. 1

TOPS	DEPTH	LOG	DATUM	Loc. in Sec.
Anh.	2410			NW NW SE
TP				
H.	3861	3860	1151	
Tr.	3884	3883	1174	
Dg.				
BL.				
L.	3902	3898	1189	Geol.
K.C.				
B.K.C.	4119	4114	1405	Contr.
Ce. <u>main</u>		4140	1431	Co. tools
C.				
M.	4415		1704	Pool
M. <u>Wilmsco B.</u>	4497			Wildcat
K.				
Mz.				
Mq.				
V.	4520	4518	1809	
S.				
S.				
A.	4601	4616	1907	ABANDONED
R.				
PE.				
G.				
TD.	4622			

Date Comm. 9-12-55 NOV 23 1955

8" @ 373/150 DST 3878-99 open $\frac{1}{2}$ hr.

rec. 5' mud 150/20" DST 3892-3941

open $1\frac{1}{2}$ hr. rec. 80' free oil 30' hocm

1090/20" DST 4039-72 open 50 min.

rec. 15' mud 580/20" $5\frac{1}{2}$ " @ 4110/125


12/ 4060-64 12. 4059-63 500 A

S/ 3. bfpb 10% oil 12/ 3902-06 S/ 173

bf (15 bo) 9 hr. reperf/ 3902-06

S/ 10 gmoph 500 A S/ $2\frac{1}{2}$ boph

S/ 1.68 boph 1/ hr. P/ 88 bo 8/10 of 1% w
P/ 27 bo 2 1/ hr. 1500 A S/ 8 bo
12 1/ boph P/ 5 bf 90% wtr.
- D & A -

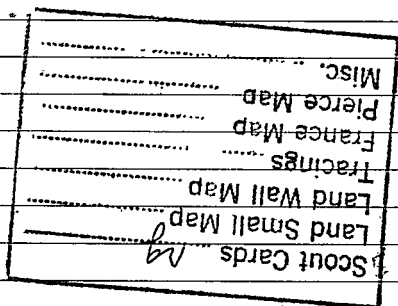

DEC 1 1955