

O.W.W.O.

FORM 51 25M 3-49 PETROL Mitchell

KANSASSection 35 Township 6 Range 7WWell No. #1 WesslingCompany Murfin Drlg.

NORTH

							0

WEST

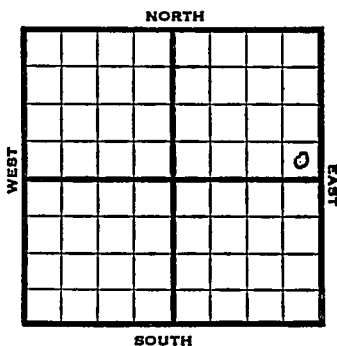
EAST

SOUTH

8

Mitchell

KANSAS

Sec. 35 Twp. 6 R. 7WWell No. #1 Wessling FarmMurfin Drlg. CompanyWildcat Contractor Ft. from N. Line330 Ft. from S. Line330 Ft. from E. Line Ft. from W. LineNE $\frac{1}{4}$ SE SE NE1952 Elev. 1414' REPORT

11/5 Location

11/12 C&P

11/20 Drlg. 1863'

11/27 Miss 3130, Gilmore City 3311,
KH 3380, Htn 3420'
Drlg. 3558'

12/3 Spud 11-14-52

D&A

TD 4113

8" @ 198

Miss 3130, Gilmore City 3311,
Kh. 3380, Hunton 3420, Viola
3532, Heeb. 2360, Simp. 3901,
Arb. 3940

TD 4113

D&A

ABANDONED**OVER**

1953

O.W.W.O.

4/1

Arb. 3940' OTD 4113'
To DD to Granite

4/9

Drlg 4185'

4/15

D&A

TD 4555'

Arb. 3940

OTD 4113

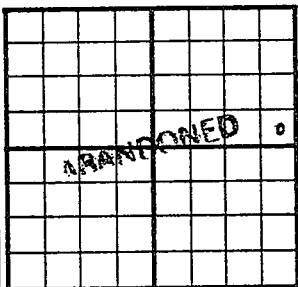
Regan 4200, Gr Wash 4369

TD 4555

D&A

ABANDONED

J. G. McGEHEE

County Mitchell State KansasSec. 35 (Blk. 6 (Sur. 7W Map No.)
(Twp.) (Rge.)Operator Murfin Drlg.Well No. 1 Farm WesslingElev. 1444 Location SE SE NE330 Ft. From S Line NE330 Ft. From E Line Quarter1st. Report Completion DEC 3 1952Remarks WildcatSpudding Date 11-14-52Drlg. Data D & A TD 41138" @ 198 Miss. 3130 Gilmore City 3311Kh. 3380 Hunton 3420 Viola 3532Heeb. 2360 Simp. 3901 Arb. 3940TD 4113D & A

J. G. McGEHEE