
DX 78-1

Graham KANSAS

Section 35 Township 6 Range 23W

Well No. 1 Casey

Company Jones, Shelburne & Farmer

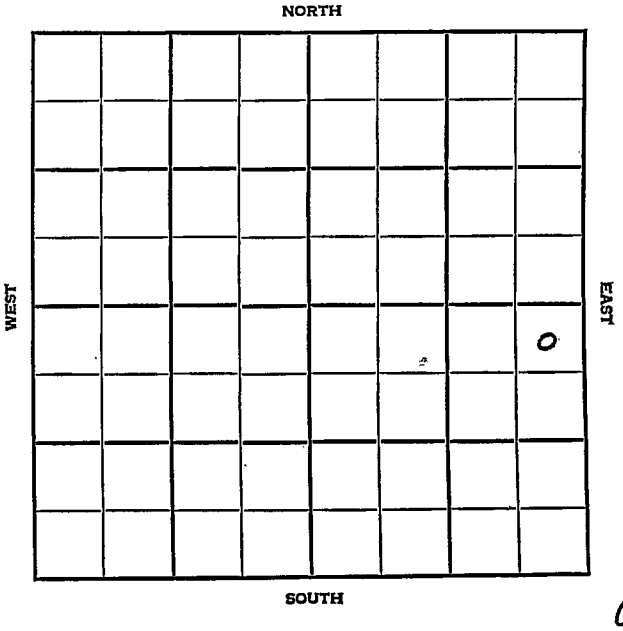

9

Graham KANSAS

SEC.	TWP.	R.
35	6	23 W

WELL NO.

1 Casey FARM

COMPANY

Jones, Shelburne & Farmer

CONTRACTOR


Wildcat

330 Ft. from N. Line

Ft. from S. Line

330 Ft. from E. Line

Ft. from W. Line

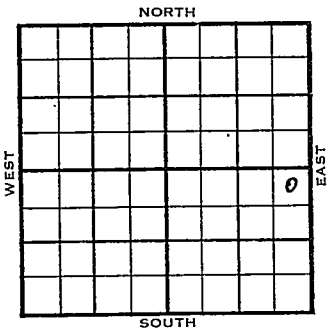

NE NE SE
Amerada & CSO - DHM
Mag. FO

	ELEVATION	REPORT
1954	2409'	
10/13		Spud 10-6-54 8" @ 180 Drlg. 3605'
10/20		Spud 10-6-54 - D&A TD 4010' 8" @ 180' Top 3430', Heeb 3637', Tor 3658', Lans 3675' DST 3728-41', opn 1 hr., rec. 130' muddy SW, 1200# B KC 3858', Arb. 4010' TD 4043' D&A

ABANDONED

DX-78

FORM 275 FOR SALE BY KANSAS BLUE PRINT CO.


County Graham State Kansas

Sec. 35 (Blk. Twp.) 6 (Sur. Rge.) 23W Map No.

Operator Jones, Shelburne & Farmer

Well No. 1 Farm Casey

Elev. 2409 Location NE NE SE

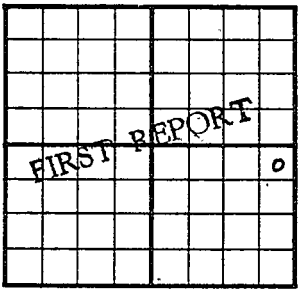

330 Ft. From N Line SE

330 Ft. From E Line Quarter

1st. Report OCT 13 1954

Completion

Remarks Mag. FO
Amerada & CSO - DHM

Spudding Date 10-6-54

Drlg. Data Wildcat

8" @ 180 drlg. 3605

FABEN GILSTRAP

FORM 275 FOR SALE BY KANSAS BLUE PRINT CO.


County Graham State Kansas

Sec. 35 (Blk. Twp.) 6 (Sur. Rge.) 23W Map No.

Operator Jones, Shelburne & Farmer

Well No. 1 Farm Casey

Elev. 2409 Location NE NE SE

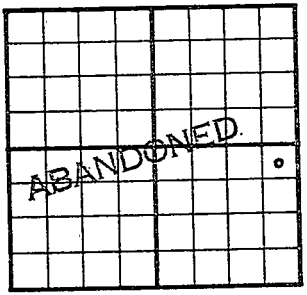

330 Ft. From N Line SE

330 Ft. From E Line Quarter

1st. Report

Completion OCT 20 1954

Remarks Wildcat

Spudding Date 10-6-54

Drlg. Data D & A TD 4010

8" @ 180 Top. 3430 Heeb. 3637

Tor. 3658 Lans. 3675 DST 3728-41

open 1 hr. Rec. 130' muddy sw 1200#

B KC 3858 Arb. 4010 TD 4043

D & A

FABEN GILSTRAP