

Section 35 Township 6 Range 19W

Well No. 1 Hindman

Company Bridgeport

Wildcat
NORTH

							0

WEST

EAST

SOUTH

KANSAS Rooks

Sec. 35 Twp. 6 R. 19W

Well No. 1 Hindman Farm
Bridgeport Company
Wildcat


330 Ft. from N. Line

_____ Ft. from S. Line

330 Ft. from E. Line

_____ Ft. from W. Line

NE/C

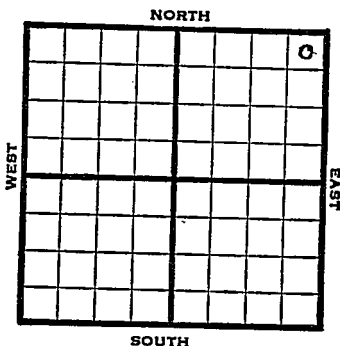

1948 Elev. 2030' . R E P O R T

8/25 8" @ 200
Drilling 885'

9/1 Drlg. 3390'

9/8 Lans. 3265'
Arb. 3538'
Reagan 3578'
TD 3590'

$$\begin{array}{r}
 3538 \\
 2030 \\
 \hline
 1508
 \end{array}$$

ABANDONED

Rooks County Kansas State

Map No. _____ Sec. 35 Twp. 6 R. 19W

Well No. 1 Hindman

Bridgeport Company

FIRST REPORT Contractor

NE/C

SECTION PLAT

330 Ft. from N. Line

_____ Ft. from S. Line

330 Ft. from E. Line

_____ Ft. from W. Line

Wildcat

Remarks:

8" @ 200 drlg. 885

Date

AUG 25 1948

Scout

S. J. LEWIS

