


Section 36 Township 6 Range 27WWell No. 1 SidesingerCompany Imperial

NORTH

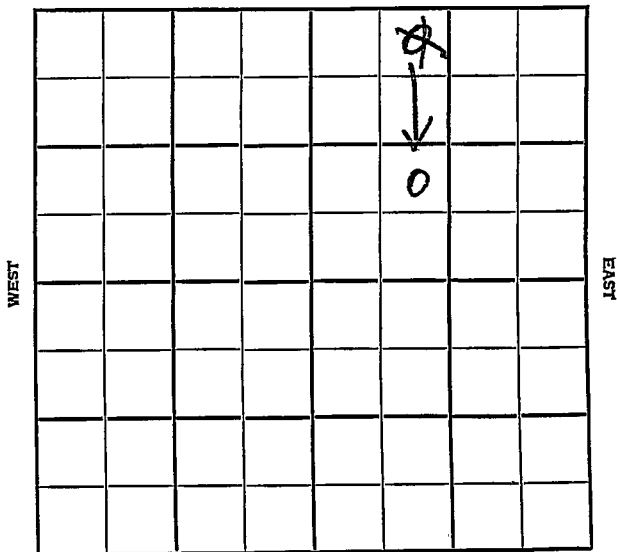

SOUTH

7

Sheridan

KANSAS

SEC.

36

TWP.

6

R.

27W

WELL NO.

1 Sidesinger

COMPANY

FARM

Imperial

CONTRACTOR

Co. Tools

Wildcat

Ft. from N. Line

990


Ft. from S. Line

Ft. from E. Line

990

Ft. from W. Line

SW
NE NW NE

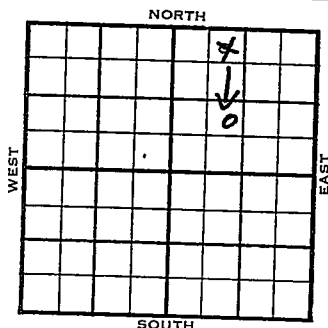

Elevation 2683

1955

2686' KB

REPORT

6/29

Comm 6-24-55

8" @ 215

Elevation 2683

Drlg 2650

7/20

720

~~Top Lansing 3872~~

~~Top Miss 4421~~

~~Top Viola 4494~~

~~Top Arbuckle 4594~~

~~Total depth 4619~~

7/13

Dry and Abandoned

Comm. 6-24-55

8" @ 215

DST 3843-66, open 45 min, rec 10' mud

35#

DST 3895-3910 open 1/2 hr rec 5' mud

30/20"

DST 3992-4012, open 1/2 hr rec 4' mud

30/20"

D & A

Tops:

Depth

Log

Anh

2363'

H

3833'

3838'

Tr

3863

L.

3872

3878

B KC

4082

Marm

4171

Miss

4421

V

4495

A

4594'

ABANDONED

TD 4619'

SCOUT TICKET

DX-201

Kansas

SEC.

36

TWP.

6

R.

27W

WELL NO.

1 Sidesinger

FARM

COMPANY

Imperial Drlg.

CONTRACTOR

CORRECTION


NE SW NE

____ FT. FROM N. LINE

990 FT. FROM S. LINE

____ FT. FORM E. LINE

990 FT. FROM W. LINE

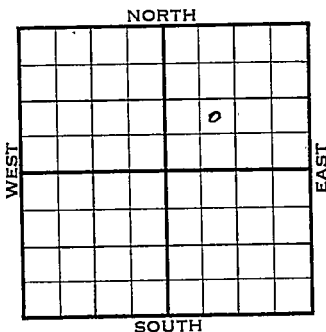

Sheridan County

☐

LOCATION

☐

RIG UP

DRILLING AND REMARKS:

Reported
NE NW NE

RECORD

CASED IN., FT.

SAND

GAS

OIL

TOTAL DEPTH

1ST 24 HRS. NAT.

1ST 24 HRS. AFTER SHOT

GAS CU. FT.

DRY HOLE

ABANDONED

PRODUCTION

DATE

JUL 6 1955

SCOUT

L. J. Harris

County	Sheridan	Elev.	
Sec.	36	Twp.	6
		Rge.	27W
Company	Imperial		
FarmName	Sidesinger		No. 1

TOPS	DEPTH	LOG	DATUM	Loc. in Sec.									
Anh.				NE NW NE									
Tp.													
H.													
Tr.													
Dg.													
Bl.													
L.				Geol.									
K.C.				Contr.									
B.K.C.				Co. tools									
Ce.													
C.													
M.				Pool									
M.				Wildcat									
K.													
Mz.													
Mq.													
V.				<table border="1" style="width:100%; border-collapse: collapse;"> <tr><td></td><td></td><td style="text-align: center;">0</td></tr> <tr><td></td><td></td><td></td></tr> <tr><td></td><td></td><td></td></tr> </table>			0						
		0											
S.													
S.													
A.													
R.													
Pe.													
G.													
T.D.													

Date Comm.	6-24-55	
	8" @ 215	drlg. 2650

23

County Sheridan Elev. 2683 DF
2686 KB
 Sec. 36 Twp. 6 Rge. 27W
 Company Imperial Drlg.
 FarmName Sidesinger No. 1

TOPS	DEPTH	LOG	DATUM
Anh.	2363		
TP.			
H.	3833	3838	1152
Tr.		3863	1177
Dg.			
BL.			
L.	3872	3878	1192
K.C.			
B.K.C.		4082	1396
Ce.			
C.			
M.	4171		1485
M.	4421		1735
K.			
Mz.			
Me.			
V.	4495		1809
S.			
S.			
A.	4594		1908
R.			
PE.			
G.			
T.D.	4619		

Loc. in Sec. NE SW NE

Geol. _____

Contr. _____

Co. tools _____

Pool _____

Wildcat _____

ABANDONED

JUL 13 1955

Date Comm. 6-24-55

8" @ 215 DST 3843-66 open 45 min.

Rec. 10' mud 35# DST 3895-3910

open $\frac{1}{2}$ hr. Rec. 5' mud 30/20"

DST 3992-4012 open $\frac{3}{8}$ hr. Rec. 4' mud
 30/20"

D & A